


Claim of Beneficial Use - Radke
Transfer T-12793

Township 11S, Range 4W, W.M.

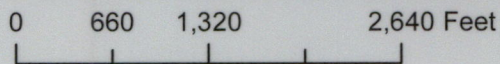

This map is not intended to provide legal dimensions or locations of property ownership lines.

Legend

- IR POU
- DLC
- Mainline
- Taxlot

Received by OWRD
NOV 08 2024
Salem, OR



EXPIRES: 12-31-2024