


Claim of Beneficial Use - Spurlin
Application G-18649, Permit G-18223

Township 12S, Range 3W, W.M.

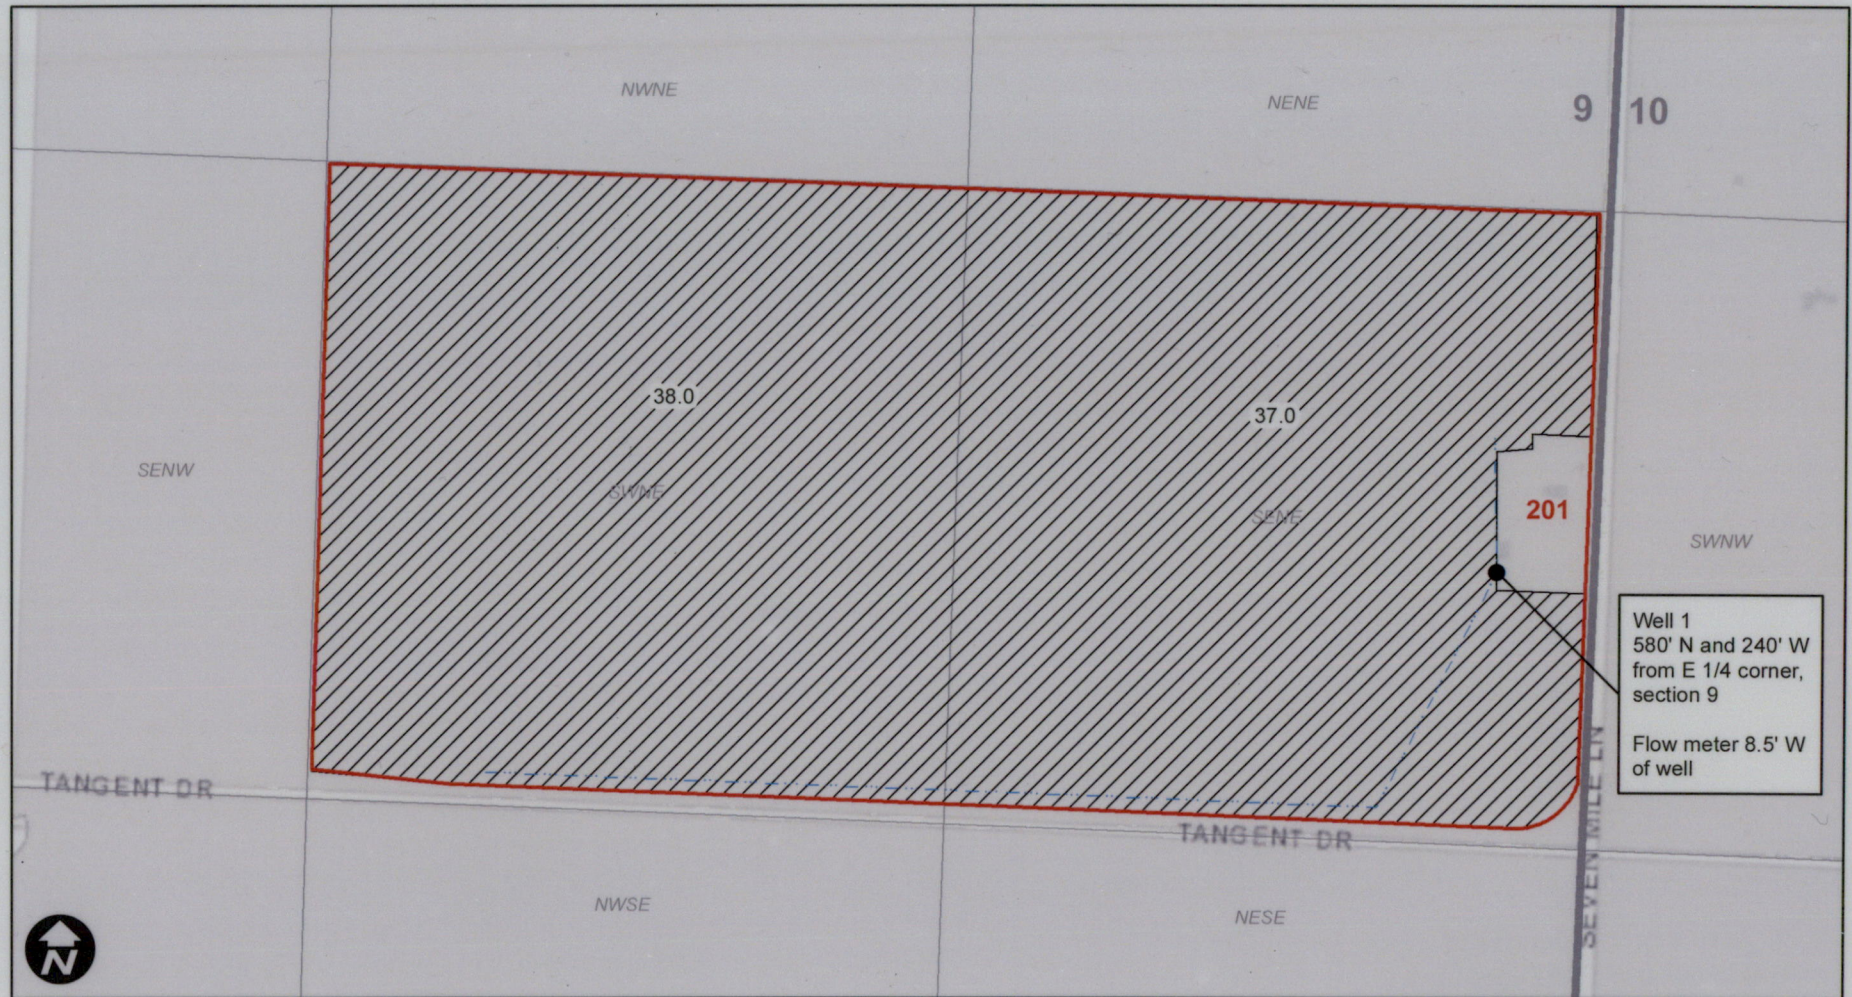

Well 1
580' N and 240' W
from E 1/4 corner,
section 9

Flow meter 8.5' W
of well

This map is not intended to provide legal dimensions or locations of property ownership lines.

Legend

IR POU Mainline Taxlots

Received by OWRD

NOV 08 2024

Salem, OR

