Claim of Beneficial Use

Permit G-17504, Application G-15802

A Water Right held by Larry Myers
Multnomah County

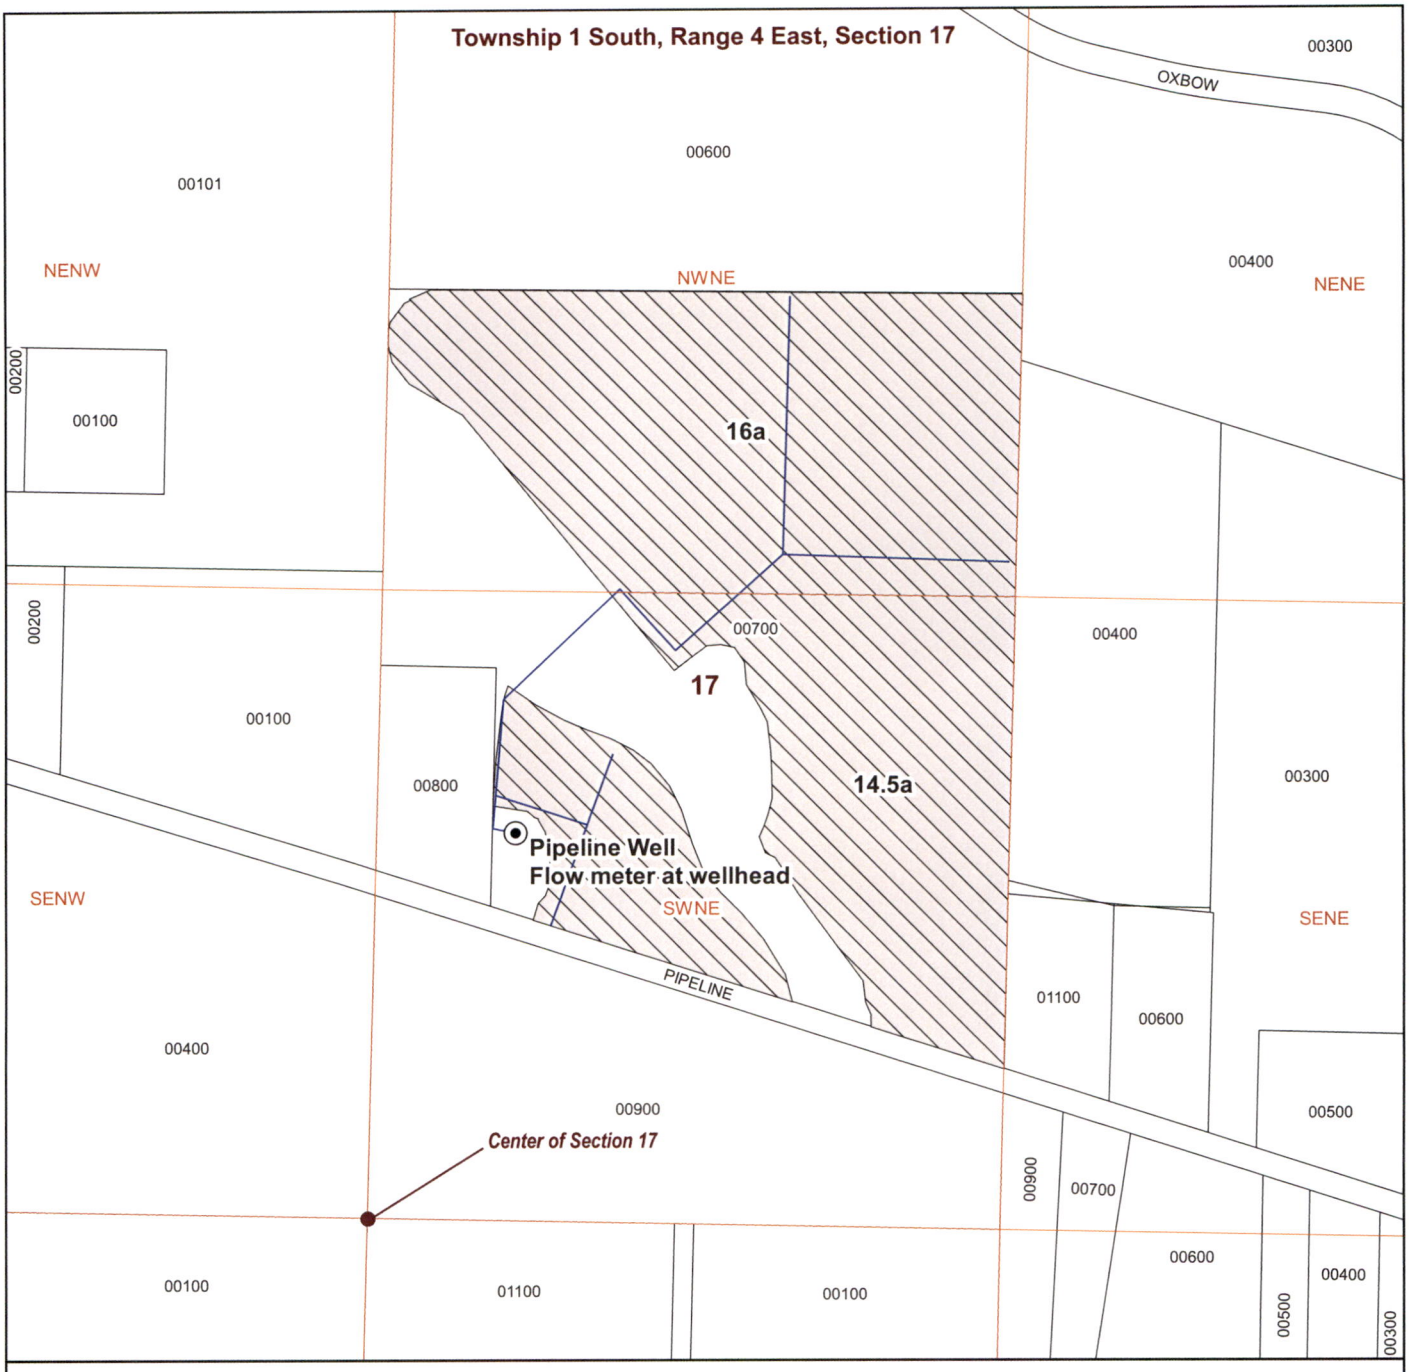

LEGEND

- Point of Appropriation (POA)
- Place of Use (POU)
- Tax lot parcels
- Water Conveyance Mainlines

POA Location Description

Pipeline Well (MULT 120173, L-118503)

RECEIVED
NOV 14 2024
OWRD

CERTIFIED WATER RIGHT EXAMINER
78185
THEODORE R RESSLER
JUNE 29, 2007
STATE OF OREGON
RENEWS: 12-31-2024

N

Scale
0 200 400 ft
1-inch = 400 feet

Date: 8/22/2024
Data Sources: BLM, OWRD, ODFW, USGS, Clackamas County.
Disclaimer: This map is not intended to provide legal dimensions or property ownership lines.

summit WATER RESOURCES

Project\Sester_Farms\1_GIS\1_SWR_Files\1_SWR_Maps\Sester_Farms_Myers.qgz