


T.6S. R.2W. Sec. 29, 30 & 31, W.M.

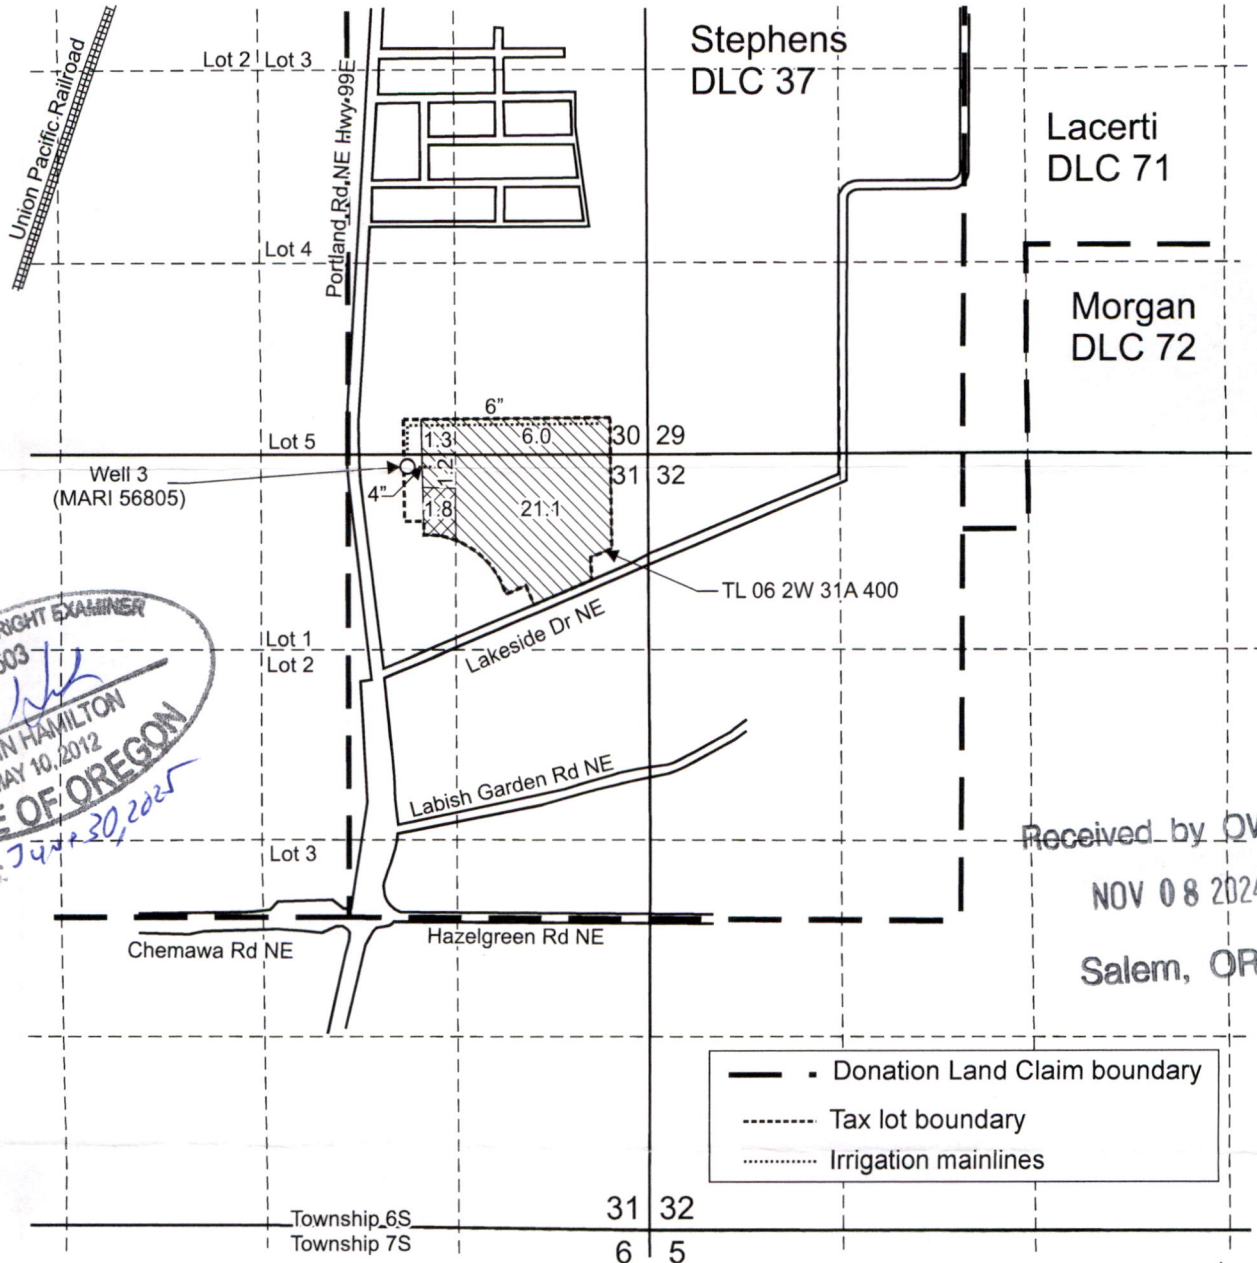


CERTIFIED WATER RIGHT EXAMINER
 85503
Doann Hamilton
DOANN HAMILTON
 MAY 10, 2012
STATE OF OREGON
 EXPIRES: 7/31/2025

Received by QWRD
 NOV 08 2024
 Salem, OR

- · — Donation Land Claim boundary
- Tax lot boundary
- Irrigation mainlines

Well 3 (MARI 56805) is located 80 feet south and 1,655 feet west from the NE corner, Section 31.

- Area (29.6 Acres) irrigated under T-13827, formerly Certificate 33475, priority date: 5-3-1961.
- Area (1.8 Acres) not irrigated under T-13827, formerly Certificate 33475, priority date: 5-3-1961.

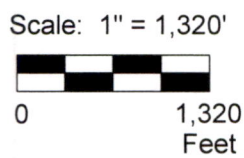

This map was prepared for the purpose of identifying the location of a water right only and is not intended to provide legal dimensions or location of property ownership lines.



Claim of Beneficial Use Map
 T-13827, formerly Certificate 33475

Coastal Forest Products
 T.6S. R.2W. Sec. 29, 30 & 31, W.M.

10/2024

Pacific Hydro-Geology Inc.

CoastaIT-13827COBUMap.cdr