


T 14 S, R 5 W, W.M.

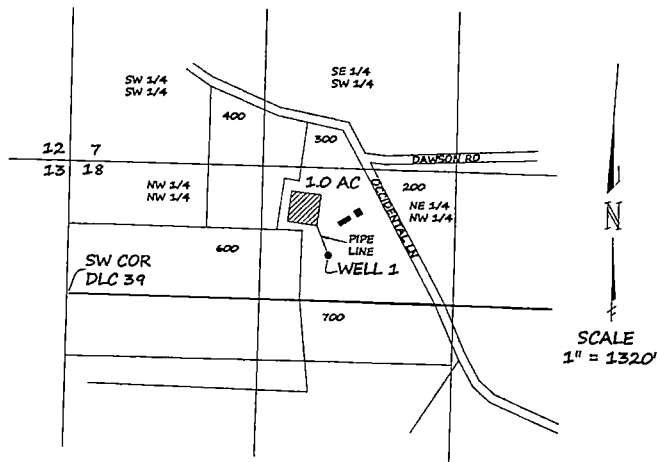

APPLICATION G-18764 PERMIT G-18250

- DENOTES WELL 1 (BENT 55689 L 123256)
LOCATION, WELL 1 & FLOW METER LOCATION
LOCATED 620.8 FT SOUTH & 2133.3 FT
EAST FROM NW COR. SEC. 18


CLAIM OF BENEFICIAL USE MAP
FOR
OREGON DREAMS LLC C/O BECKI SELLS
25664 OCCIDENTAL LANE
MONROE, OR 97456

■ DENOTES BUILDING LOCATION

BY
H. TIMOTHY FASSBENDER, PLS, CWRE
2896 SARAH LANE
EUGENE, OR 97408
OCTOBER 14, 2024

▨ DENOTES AREA OF BENEFICIAL USE

NOTE:
THE PREPARATION OF THE MAP WAS
FOR THE PURPOSE OF IDENTIFYING THE
LOCATION OF THE WATER RIGHT ONLY.
IT IS NOT INTENDED TO PROVIDE
LOCATION NOR DIMENSIONS OF PROPERTY
OWNERSHIP LINES.

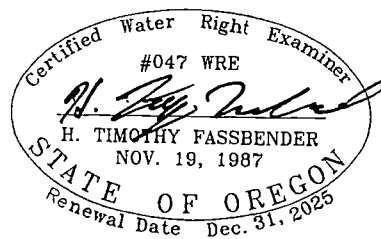

Received

NOV 22 2024

OWRD