


Claim of Beneficial Use - Immaculate Conception Church
 Application G-18484, Permit G-17973

Township 9S, Range 1W, W.M.



This map is not intended to provide legal dimensions or locations of property ownership lines.

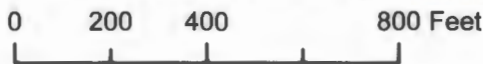

Legend

- IR POU
- Mainline
- Taxlot



EXPIRES: 12-31-2024