


CLAIM of BENEFICIAL USE MAP

FOR: GREGORY TIMM
BY: NATHAN REED, PE, CWRE
T27S, R6W, W.M. SECTION 14
APPLICATION NO. S-88769
PERMIT NO. S-55229



SCALE: 1" = 400'

DATE OF SURVEY: SEPTEMBER 13, 2024

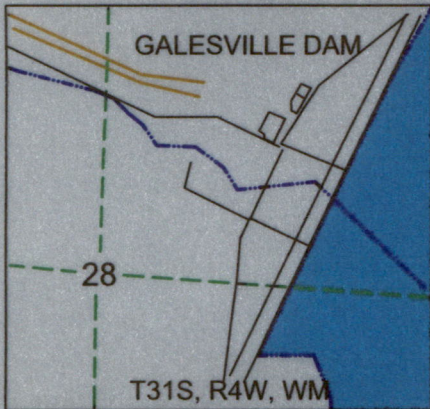

SCALE: 1" = 400'




Received
DEC 02 2024
OWRD

POD IS LOCATED 430 FEET SOUTH & 840 FEET WEST OF C1/4 CORNER OF SECTION 14.

Received
OCT 18 2024
OWRD

LEGEND

	WATER		QUARTER
	POD		SIXTEENTH
	PUMP		DLC
	METER		GLOT
	PIPE		PARCEL
	MEANDER		IRRIGATION

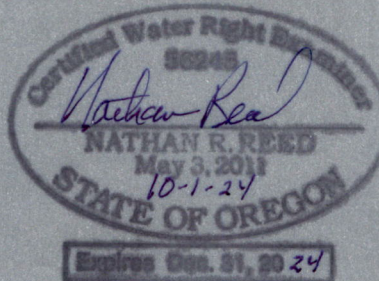

MAP PREPARED FOR:
GREGORY TIMM
1224 NW RIVERFRONT DR.
ROSEBURG, OR 97471

MAP PREPARED BY:
NATHAN REED PE, CWRE
157 WEST BODIE STREET
ROSEBURG, OR 97471

THE PURPOSE OF THIS MAP IS TO IDENTIFY THE LOCATION OF THE WATER RIGHT. IT IS NOT INTENDED TO PROVIDE INFORMATION RELATIVE TO THE LOCATION OF PROPERTY OWNERSHIP BOUNDARY LINES.