


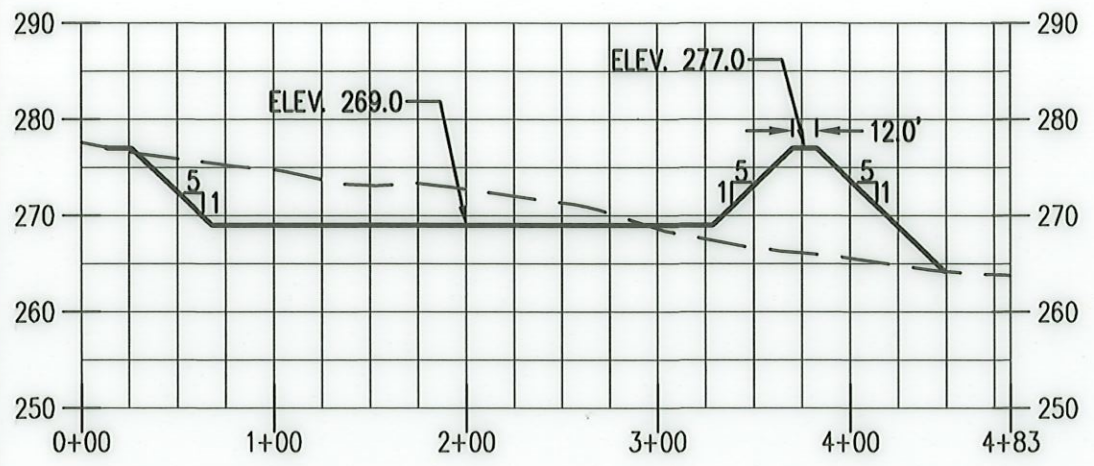
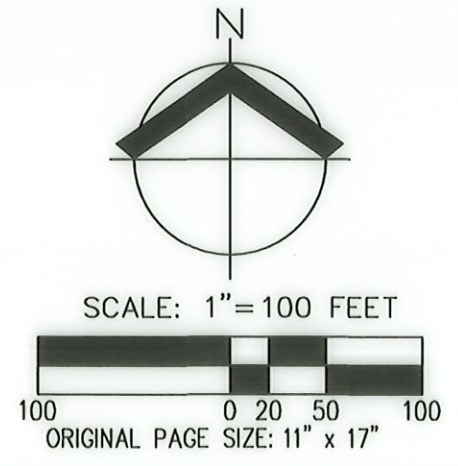


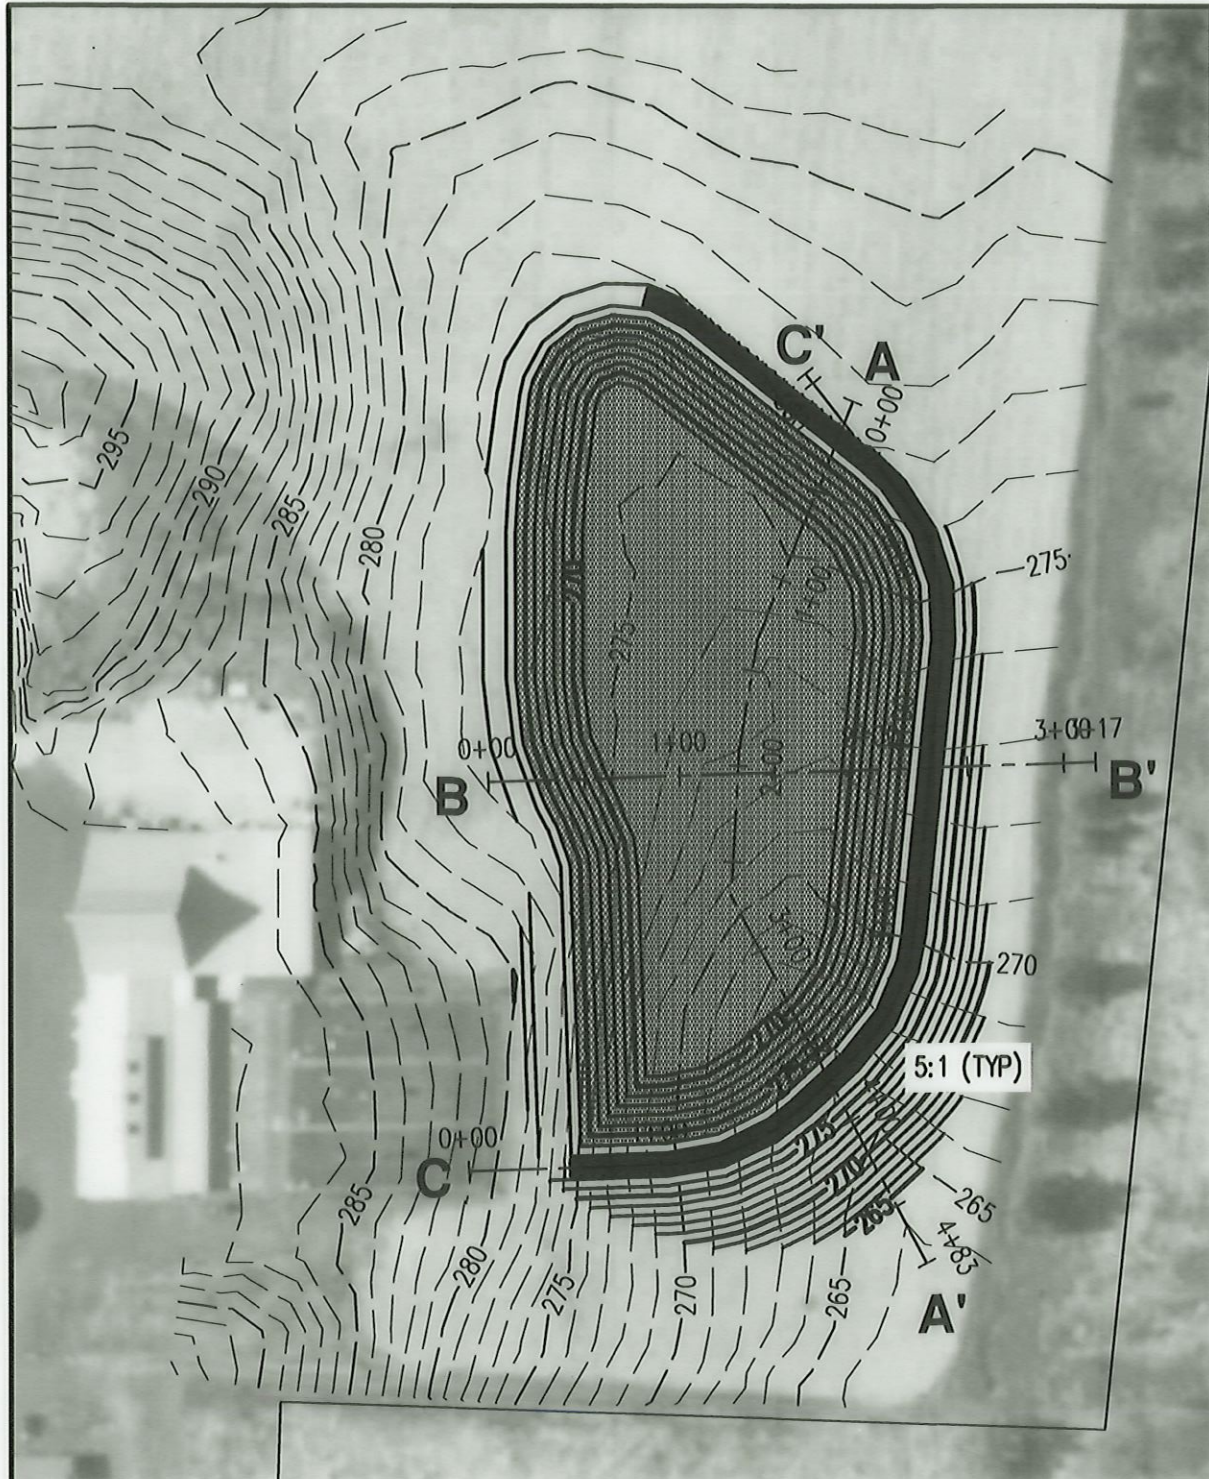

A-A'
 Hor. Scale: 1" = 100'
 Vert. Scale: 1" = 20'

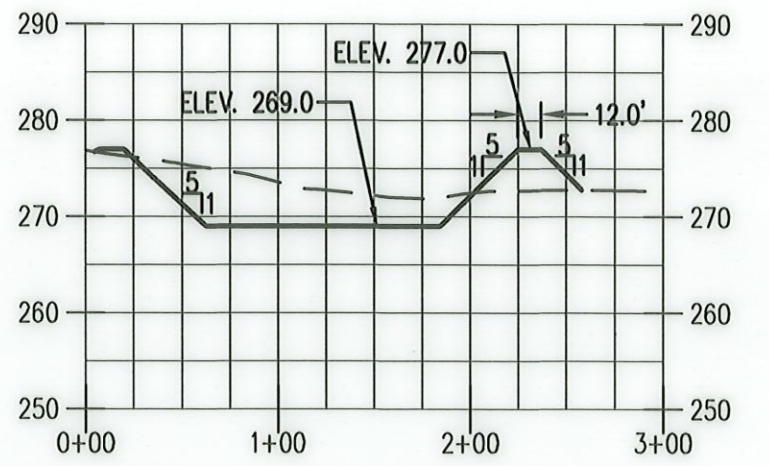

B-B'
 Hor. Scale: 1" = 100'
 Vert. Scale: 1" = 20'

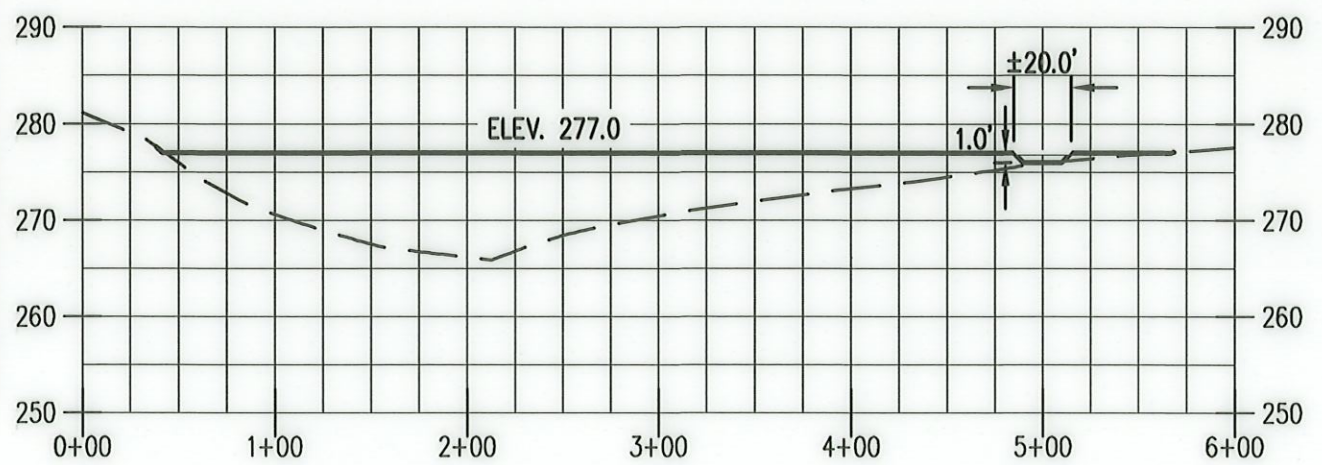

C-C'
 Hor. Scale: 1" = 100'
 Vert. Scale: 1" = 20'


Received
 DEC 02 2024
 OWRD

DATE: 10/09/2024



POND EMBANKMENT CROSS SECTIONS		EXHIBIT
10280 NE ABBEY ROAD		B
AKS ENGINEERING & FORESTRY, LLC		DRWN: BGZ
12965 SW HERMAN RD, STE 100		CHKD: SRR
TUALATIN, OR 97062		AKS JOB:
503.563.6151 WWW.AKS-ENG.COM		6241



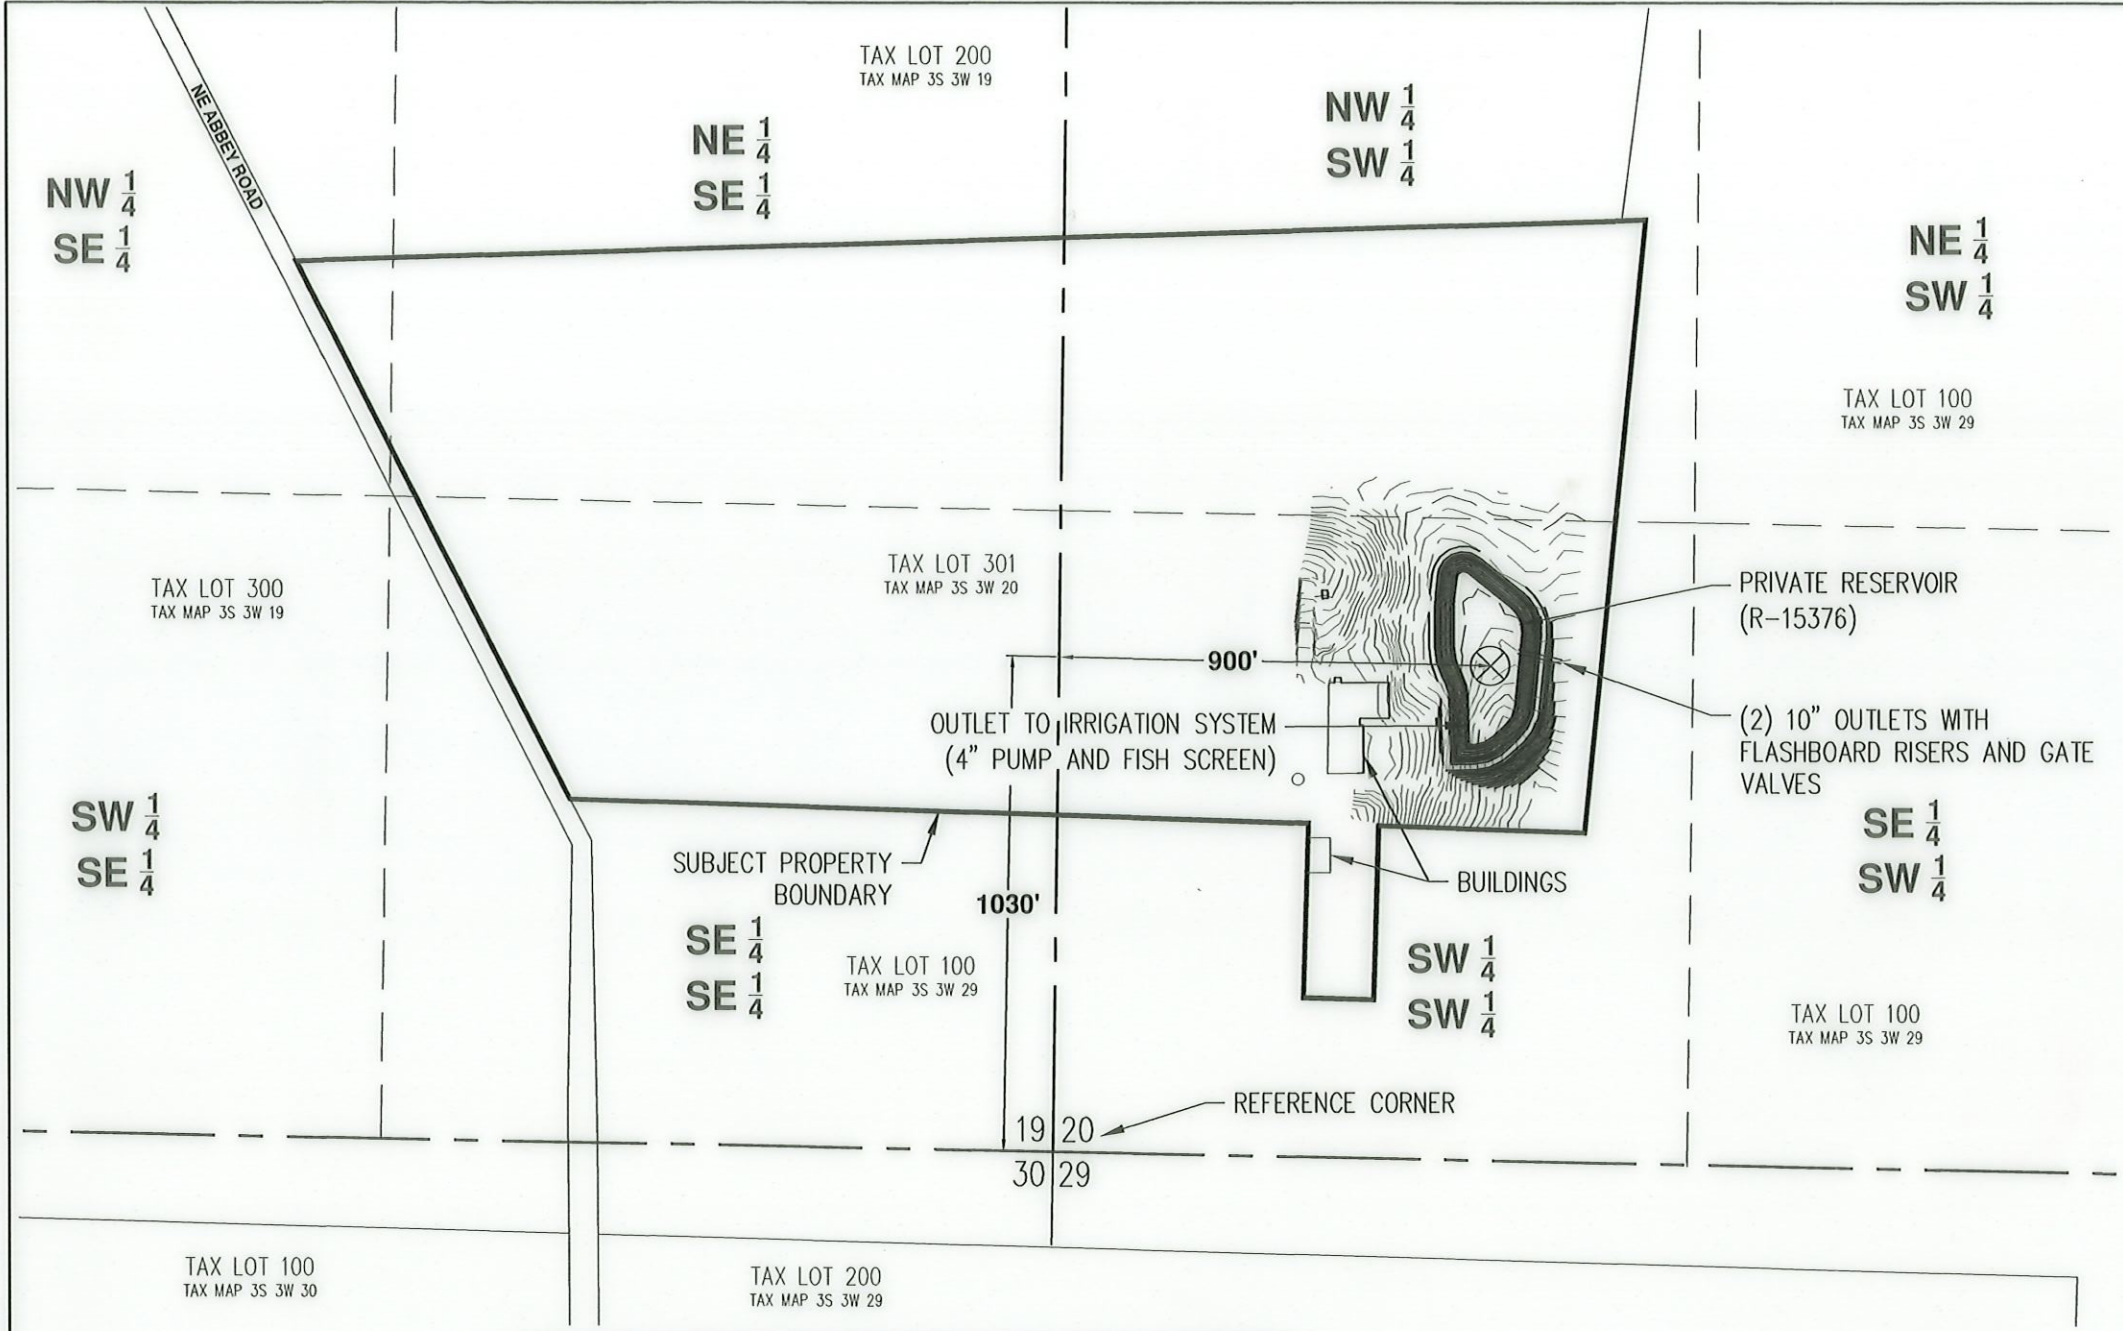


LOCATED IN SECTIONS 19 & 20,
T3S, R3W, WM
YAMHILL COUNTY, OREGON

CLAIM OF BENEFICIAL USE MAP

UNDER: APPLICATION R-88675
PERMIT R-15376

TAX LOT 301
TAX MAP 3S 3W 20

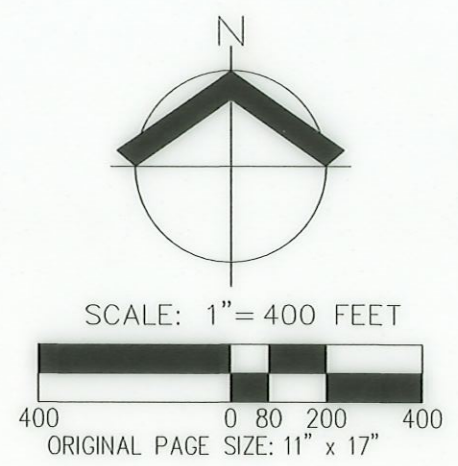

LEGEND

POINT OF APPROPRIATION (POA)

TAX LOT BOUNDARY

1/4 1/4 SECTION LINE

SECTION LINE

PRIVATE RESERVOIR (STORAGE POND)
TOTAL = 8.75 ACRES-FEET

CWRE STATEMENT

THIS MAP IS NOT INTENDED TO PROVIDE LEGAL DIMENSIONS OF LOCATIONS OF PROPERTY OWNERSHIP LINES.

MAP INFORMATION

COORDINATE SYSTEM: STATE PLANE OREGON NORTH ZONE 3601
DATUM: NORTH AMERICAN DATUM OF 1983

DATA SOURCES

TAX LOT AND ROAD: YAMHILL COUNTY GIS
SECTION LINEWORK: OREGON DEPARTMENT OF WATER RESOURCES

PREPARED FOR

RYAN RHEA
10280 NE ABBEY ROAD, CARLTON, OR 97111

DATE: 10/23/2024

Received
DEC 02 2024
OWRD



CLAIM OF BENEFICIAL USE MAP		EXHIBIT A
10280 NE ABBEY ROAD		DRWN: BGZ
AKS ENGINEERING & FORESTRY, LLC 12965 SW HERMAN ROAD, SUITE 100 TUALATIN, OR 97062 503.563.6151 WWW.AKS-ENG.COM		CHKD: SRR
		AKS JOB: 6241

