
## CLAIM OF BENEFICIAL USE MAP

TO CHANGE PLACE OF USE PER T-14095 FOR RUSSELL MATTIS

TOWNSHIP 26 SOUTH, RANGE 14 EAST, SECTIONS 30 & 31, W.M. TAX LOTS: 1400 & 2200

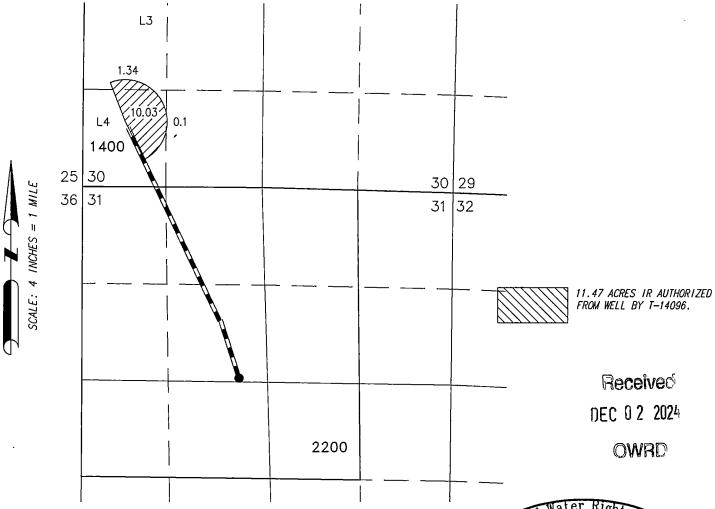

• WELL (LAKE 367)

LOCATED IN THE SE 1/4 NW 1/4 SECTION 31, T26S R14E, W.M. AND 2600 FEET SOUTH AND 2900 FEET WEST FROM THE NE CORNER OF SAID SECTION. FLOW METER IS ON PIPE 7.0' NE FROM WELL. SECOND FLOW METER IS ON PIPE 6.0' EAST FROM NORTH CENTER PIVOT SPRINKLER



RENEWAL DATE: 12/31/2024

THIS MAP IS FOR THE PURPOSE OF LOCATING A WATER RIGHT ONLY AND HAS NO INTENT TO PROVIDE LEGAL DIMENSIONS OR THE LOCATION OF PROPERTY LINES.

PREPARED FOR:

RUSS MATTIS P.O. BOX 87 FT. ROCK, OR 97735 PREPARED BY:



ALL POINTS ENGINEERING AND SURVEYING, INC. P.O. BOX 767 TERREBONNE, OR 97760 (541) 548-5833 www.APEandS.com