



CLAIM OF BENEFICIAL USE MAP

TO CHANGE PLACE OF USE PER T-14096
FOR RUSSELL MATTIS

TOWNSHIP 26 SOUTH, RANGE 14 EAST, SECTION 28, W.M.
TAX LOT: 2100

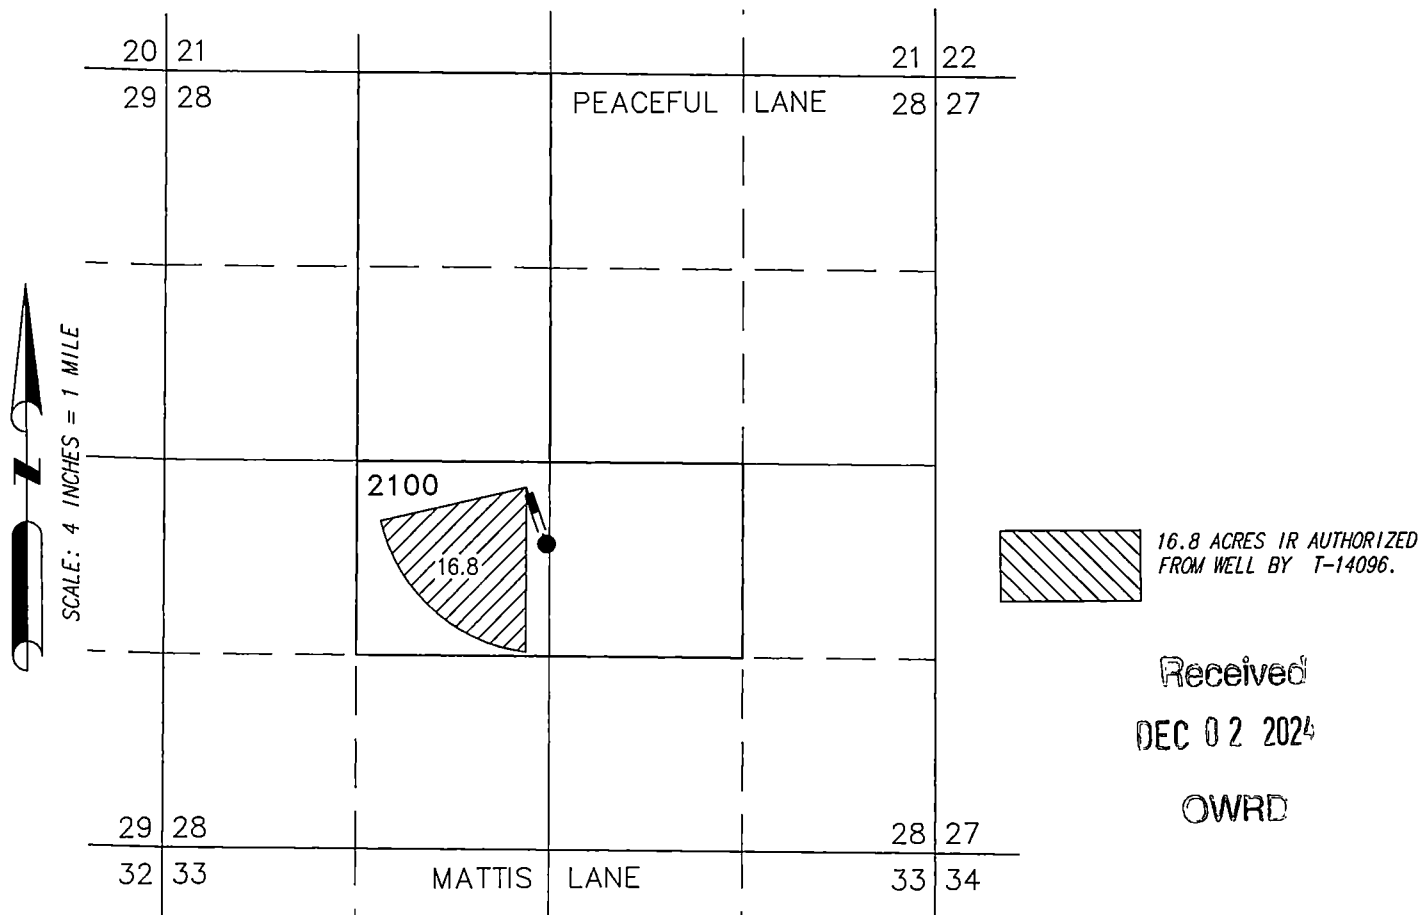

- WELL (LAKE 364/365)
LOCATED IN THE NE 1/4 SW 1/4 SECTION 28, T26S
R14E, W.M. AND 560 FEET SOUTH AND 20 FEET WEST
FROM THE C1/4 CORNER OF SAID SECTION.
FLOW METER IS ON PIPE 3.0' NORTH FROM WELL.

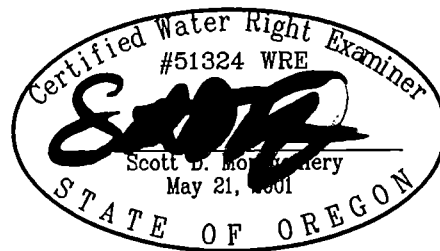

RENEWAL DATE: 12/31/2024

THIS MAP IS FOR THE PURPOSE OF LOCATING A WATER
RIGHT ONLY AND HAS NO INTENT TO PROVIDE LEGAL
DIMENSIONS OR THE LOCATION OF PROPERTY LINES.

PREPARED FOR:

RUSS MATTIS
P.O. BOX 87
FT. ROCK, OR 97735

PREPARED BY:




ALL POINTS ENGINEERING AND SURVEYING, INC.
P.O. BOX 767 TERREBONNE, OR 97760
(541) 548-5833 www.APEandS.com

CLAIM OF BENEFICIAL USE MAP

TO CHANGE PLACE OF USE PER T-14095
FOR RUSSELL MATTIS

TOWNSHIP 26 SOUTH, RANGE 14 EAST, SECTIONS 30 & 31, W.M.
TAX LOTS: 1400 & 2200

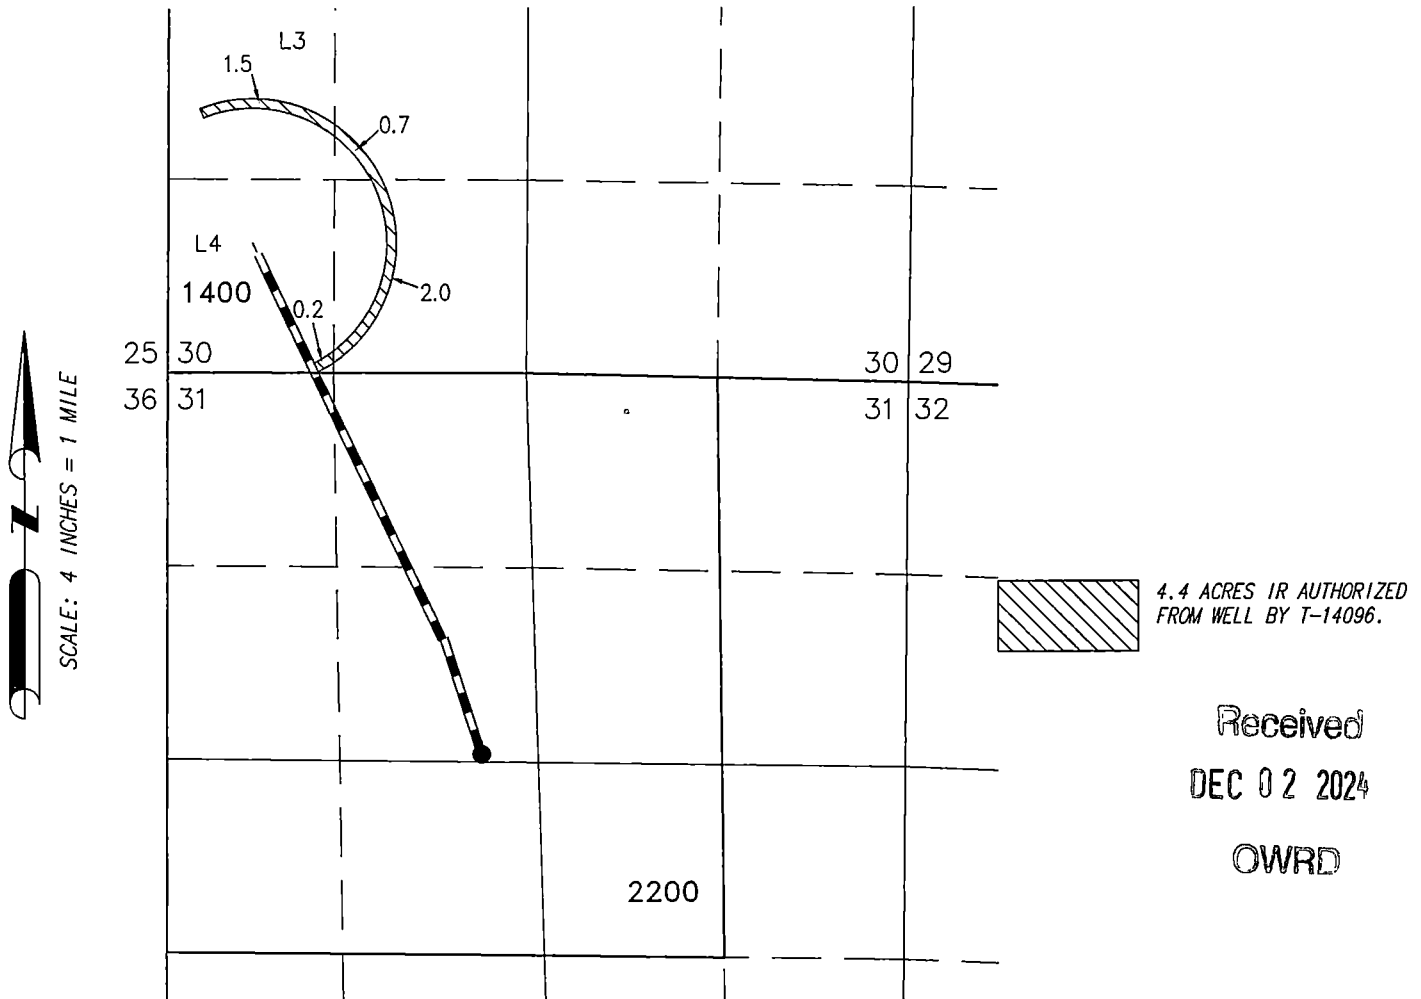

Received


DEC 02 2024

OWRD

● WELL (LAKE 367)

LOCATED IN THE SE 1/4 NW 1/4 SECTION 31, T26S
R14E, W.M. AND 2600 FEET SOUTH AND 2900 FEET WEST
FROM THE NE CORNER OF SAID SECTION.

FLOW METER IS ON PIPE 7.0' NE FROM WELL. SECOND
FLOW METER IS ON PIPE 6.0' EAST FROM NORTH CENTER
PIVOT SPRINKLER

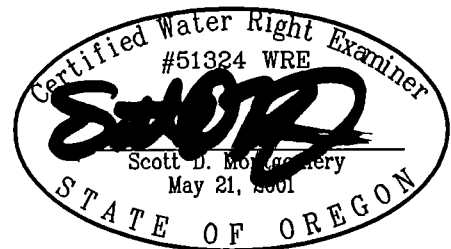

RENEWAL DATE: 12/31/2024

THIS MAP IS FOR THE PURPOSE OF LOCATING A WATER
RIGHT ONLY AND HAS NO INTENT TO PROVIDE LEGAL
DIMENSIONS OR THE LOCATION OF PROPERTY LINES.

PREPARED FOR:

RUSSELL MATTIS
P.O. BOX 87
FT. ROCK, OR 97735

PREPARED BY:




ALL POINTS ENGINEERING AND SURVEYING, INC.
P.O. BOX 767
(541) 548-5833
TERREBONNE, OR 97760
www.APEandS.com


CLAIM OF BENEFICIAL USE MAP

TO CHANGE PLACE OF USE PER T-14095
FOR RUSSELL MATTIS

TOWNSHIP 26 SOUTH, RANGE 14 EAST, SECTIONS 30 & 31, W.M.
TAX LOTS: 1400 & 2200

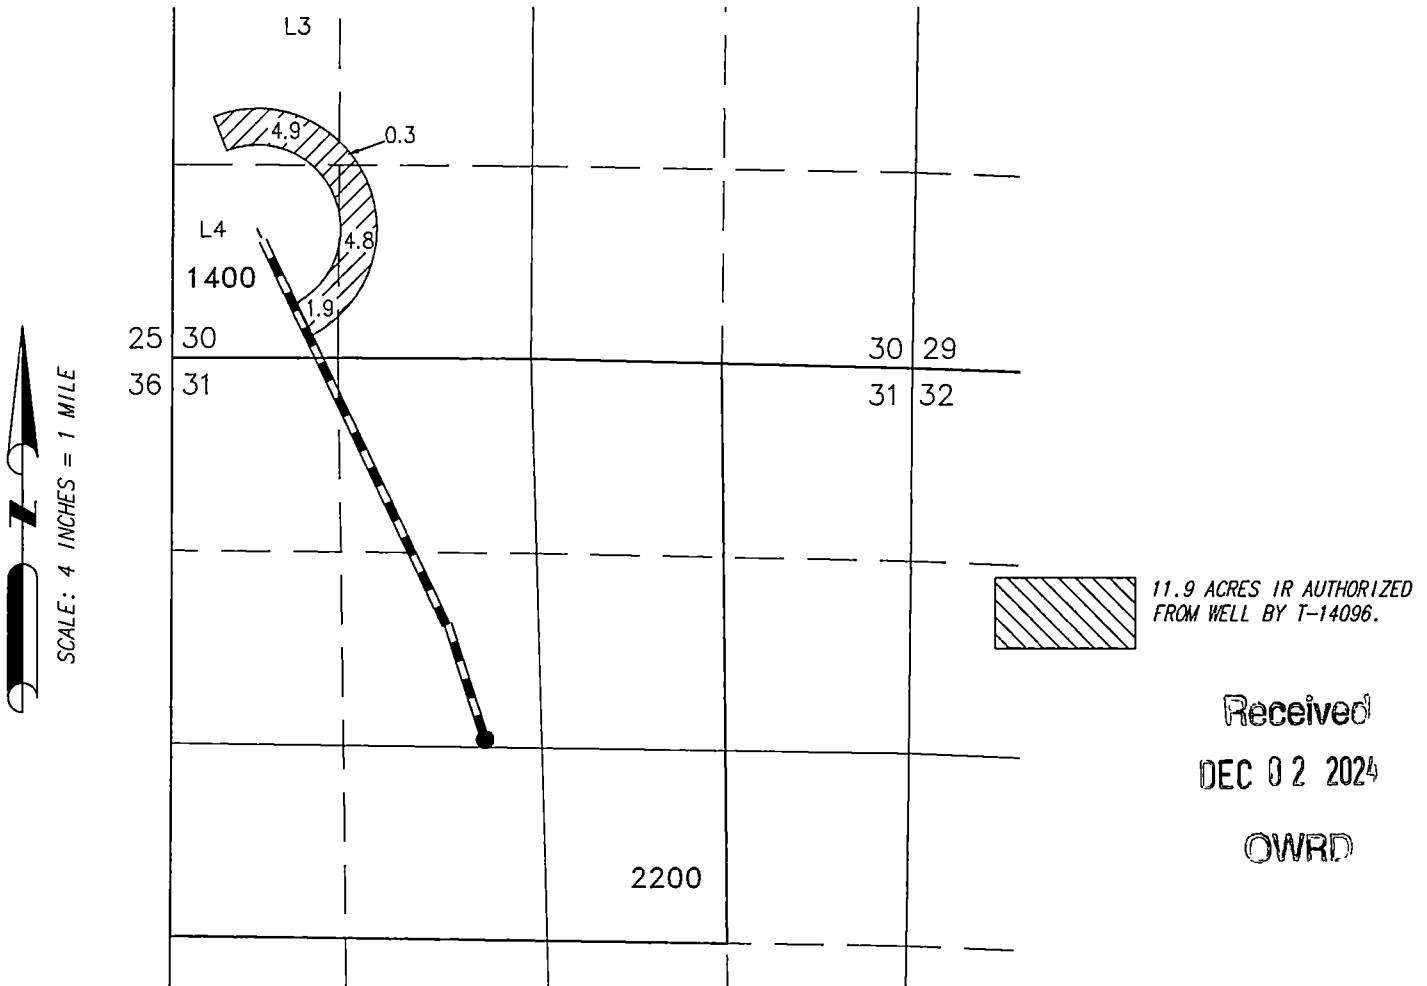

- WELL (LAKE 367)
LOCATED IN THE SE 1/4 NW 1/4 SECTION 31, T26S
R14E, W.M. AND 2600 FEET SOUTH AND 2900 FEET WEST
FROM THE NE CORNER OF SAID SECTION.
FLOW METER IS ON PIPE 7.0' NE FROM WELL. SECOND
FLOW METER IS ON PIPE 6.0' EAST FROM NORTH CENTER
PIVOT SPRINKLER

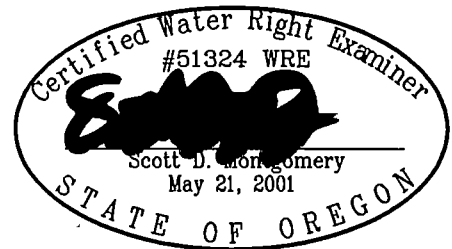

RENEWAL DATE: 12/31/2024

THIS MAP IS FOR THE PURPOSE OF LOCATING A WATER
RIGHT ONLY AND HAS NO INTENT TO PROVIDE LEGAL
DIMENSIONS OR THE LOCATION OF PROPERTY LINES.

PREPARED FOR:

RUSSELL MATTIS
P.O. BOX 87
FT. ROCK, OR 97735

PREPARED BY:




ALL POINTS ENGINEERING AND SURVEYING, INC.
P.O. BOX 767
(541) 548-5833
TERREBONNE, OR 97760
www.APEandS.com

CLAIM OF BENEFICIAL USE MAP


TO CHANGE PLACE OF USE PER T-14095
FOR RUSSELL MATTIS

TOWNSHIP 26 SOUTH, RANGE 14 EAST, SECTIONS 30 & 31, W.M.
TAX LOTS: 1400 & 2200

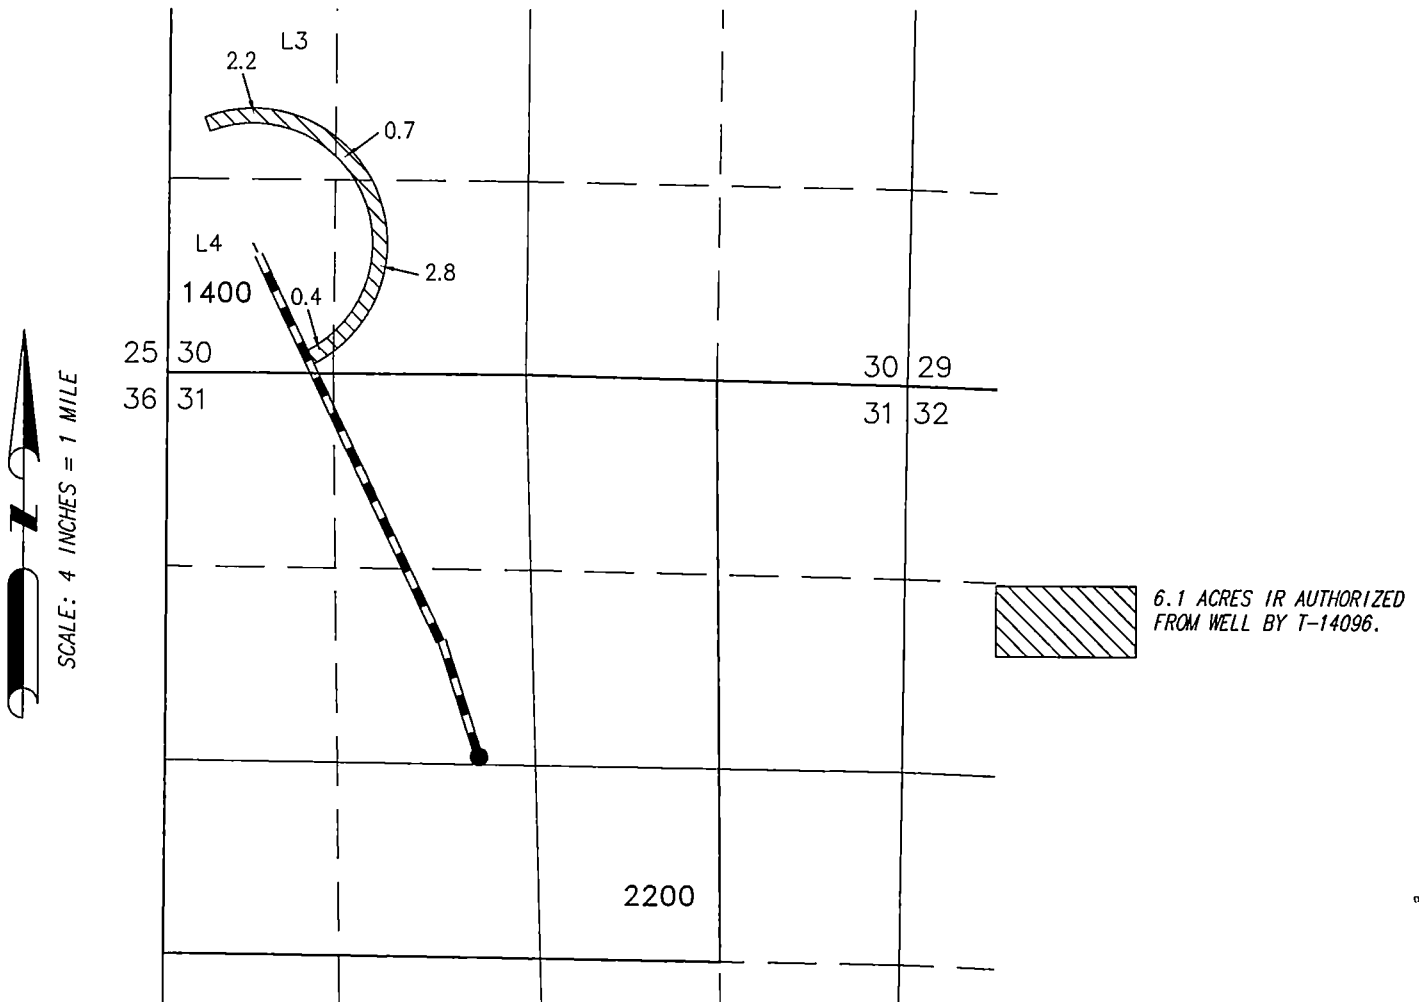

● WELL (LAKE 367)

LOCATED IN THE SE 1/4 NW 1/4 SECTION 31, T26S
R14E, W.M. AND 2600 FEET SOUTH AND 2900 FEET WEST
FROM THE NE CORNER OF SAID SECTION.
FLOW METER IS ON PIPE 7.0' NE FROM WELL. SECOND
FLOW METER IS ON PIPE 6.0' EAST FROM NORTH CENTER
PIVOT SPRINKLER

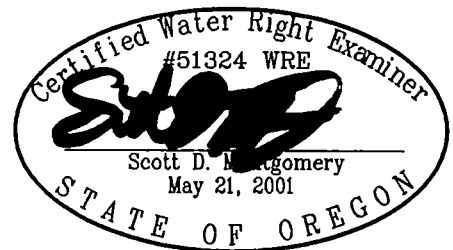

RENEWAL DATE: 12/31/2024

THIS MAP IS FOR THE PURPOSE OF LOCATING A WATER
RIGHT ONLY AND HAS NO INTENT TO PROVIDE LEGAL
DIMENSIONS OR THE LOCATION OF PROPERTY LINES.

PREPARED FOR:

RUSSELL MATTIS
P.O. BOX 87
FT. ROCK, OR 97735

PREPARED BY:



ALL POINTS ENGINEERING AND SURVEYING, INC.
P.O. BOX 767
(541) 548-5833
TERREBONNE, OR 97760
www.APEandS.com