


Claim of Beneficial Use - Wand Application R-72499, Permit R-11476

Township 7S, Range 11W, W.M.

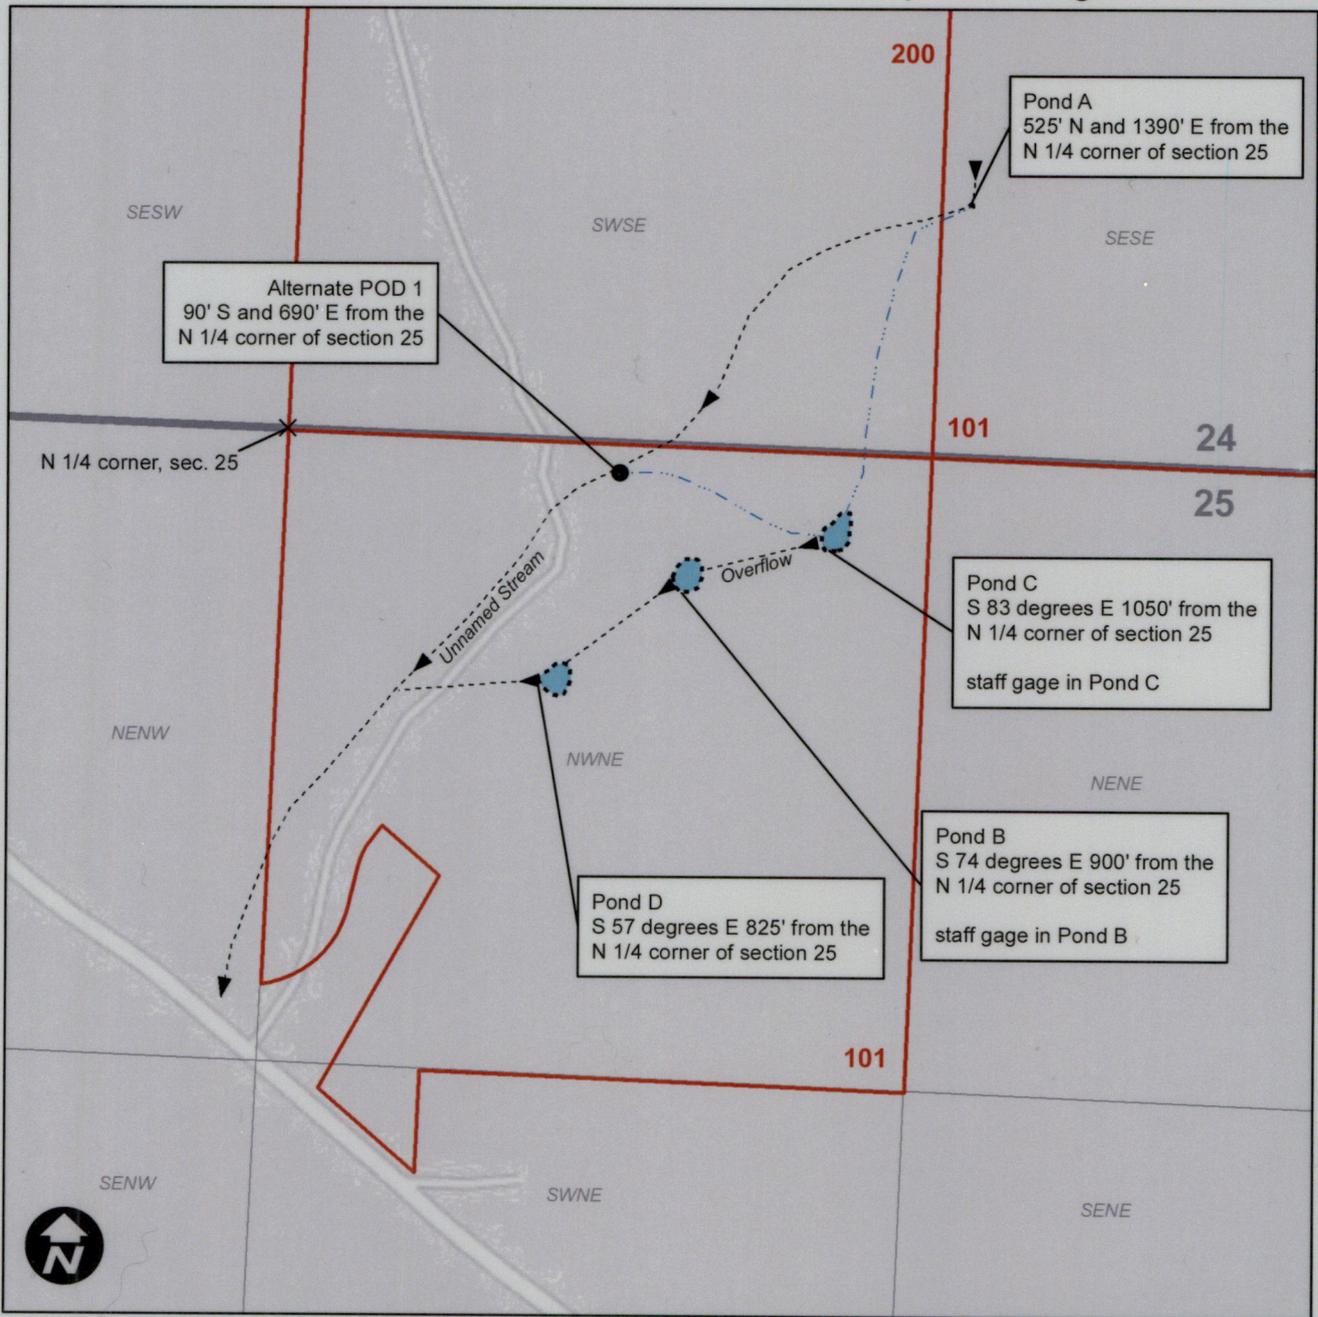

Alternate POD 1
90' S and 690' E from the
N 1/4 corner of section 25

N 1/4 corner, sec. 25

Pond A
525' N and 1390' E from the
N 1/4 corner of section 25

Pond C
S 83 degrees E 1050' from the
N 1/4 corner of section 25
staff gage in Pond C

Pond B
S 74 degrees E 900' from the
N 1/4 corner of section 25
staff gage in Pond B

Pond D
S 57 degrees E 825' from the
N 1/4 corner of section 25



0 200 400 800 Feet

This map is not intended to provide legal dimensions or locations of property ownership lines.

Legend

- Pipeline
- Ponds
- Taxlots



Received by OWRD

DEC 11 2024

EXPIRES: 12-31-2026

Salem, OR