

CLAIM OF BENEFICIAL USE MAP

APPLICATION: S-88493, PERMIT: S-55166
PRIORITY DATE: 1/4/2018
IRRIGATION

FOR
WILLIAM D. LEAVENS
8561 HIGH BANKS ROAD
CENTRAL POINT, OR 97502
SITUATED IN


SECTIONS 15, 16, 21, TOWNSHIP 36 SOUTH, RANGE 2 WEST, W.M.
JACKSON COUNTY, OREGON

Received by OWRD


DEC 11 2024

Salem, OR

SW/NE

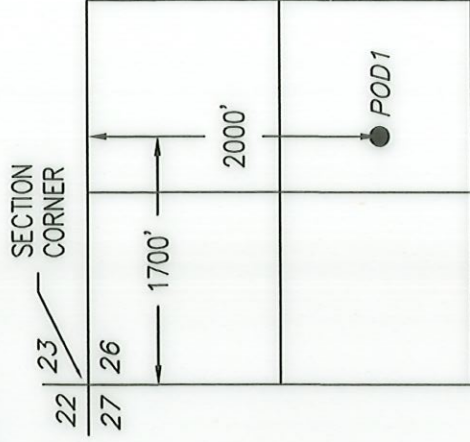


LOST CREEK RESERVOIR
POINT OF DIVERSION
T.33S., R.1E., W.M.
SCALE: 1"=1320'

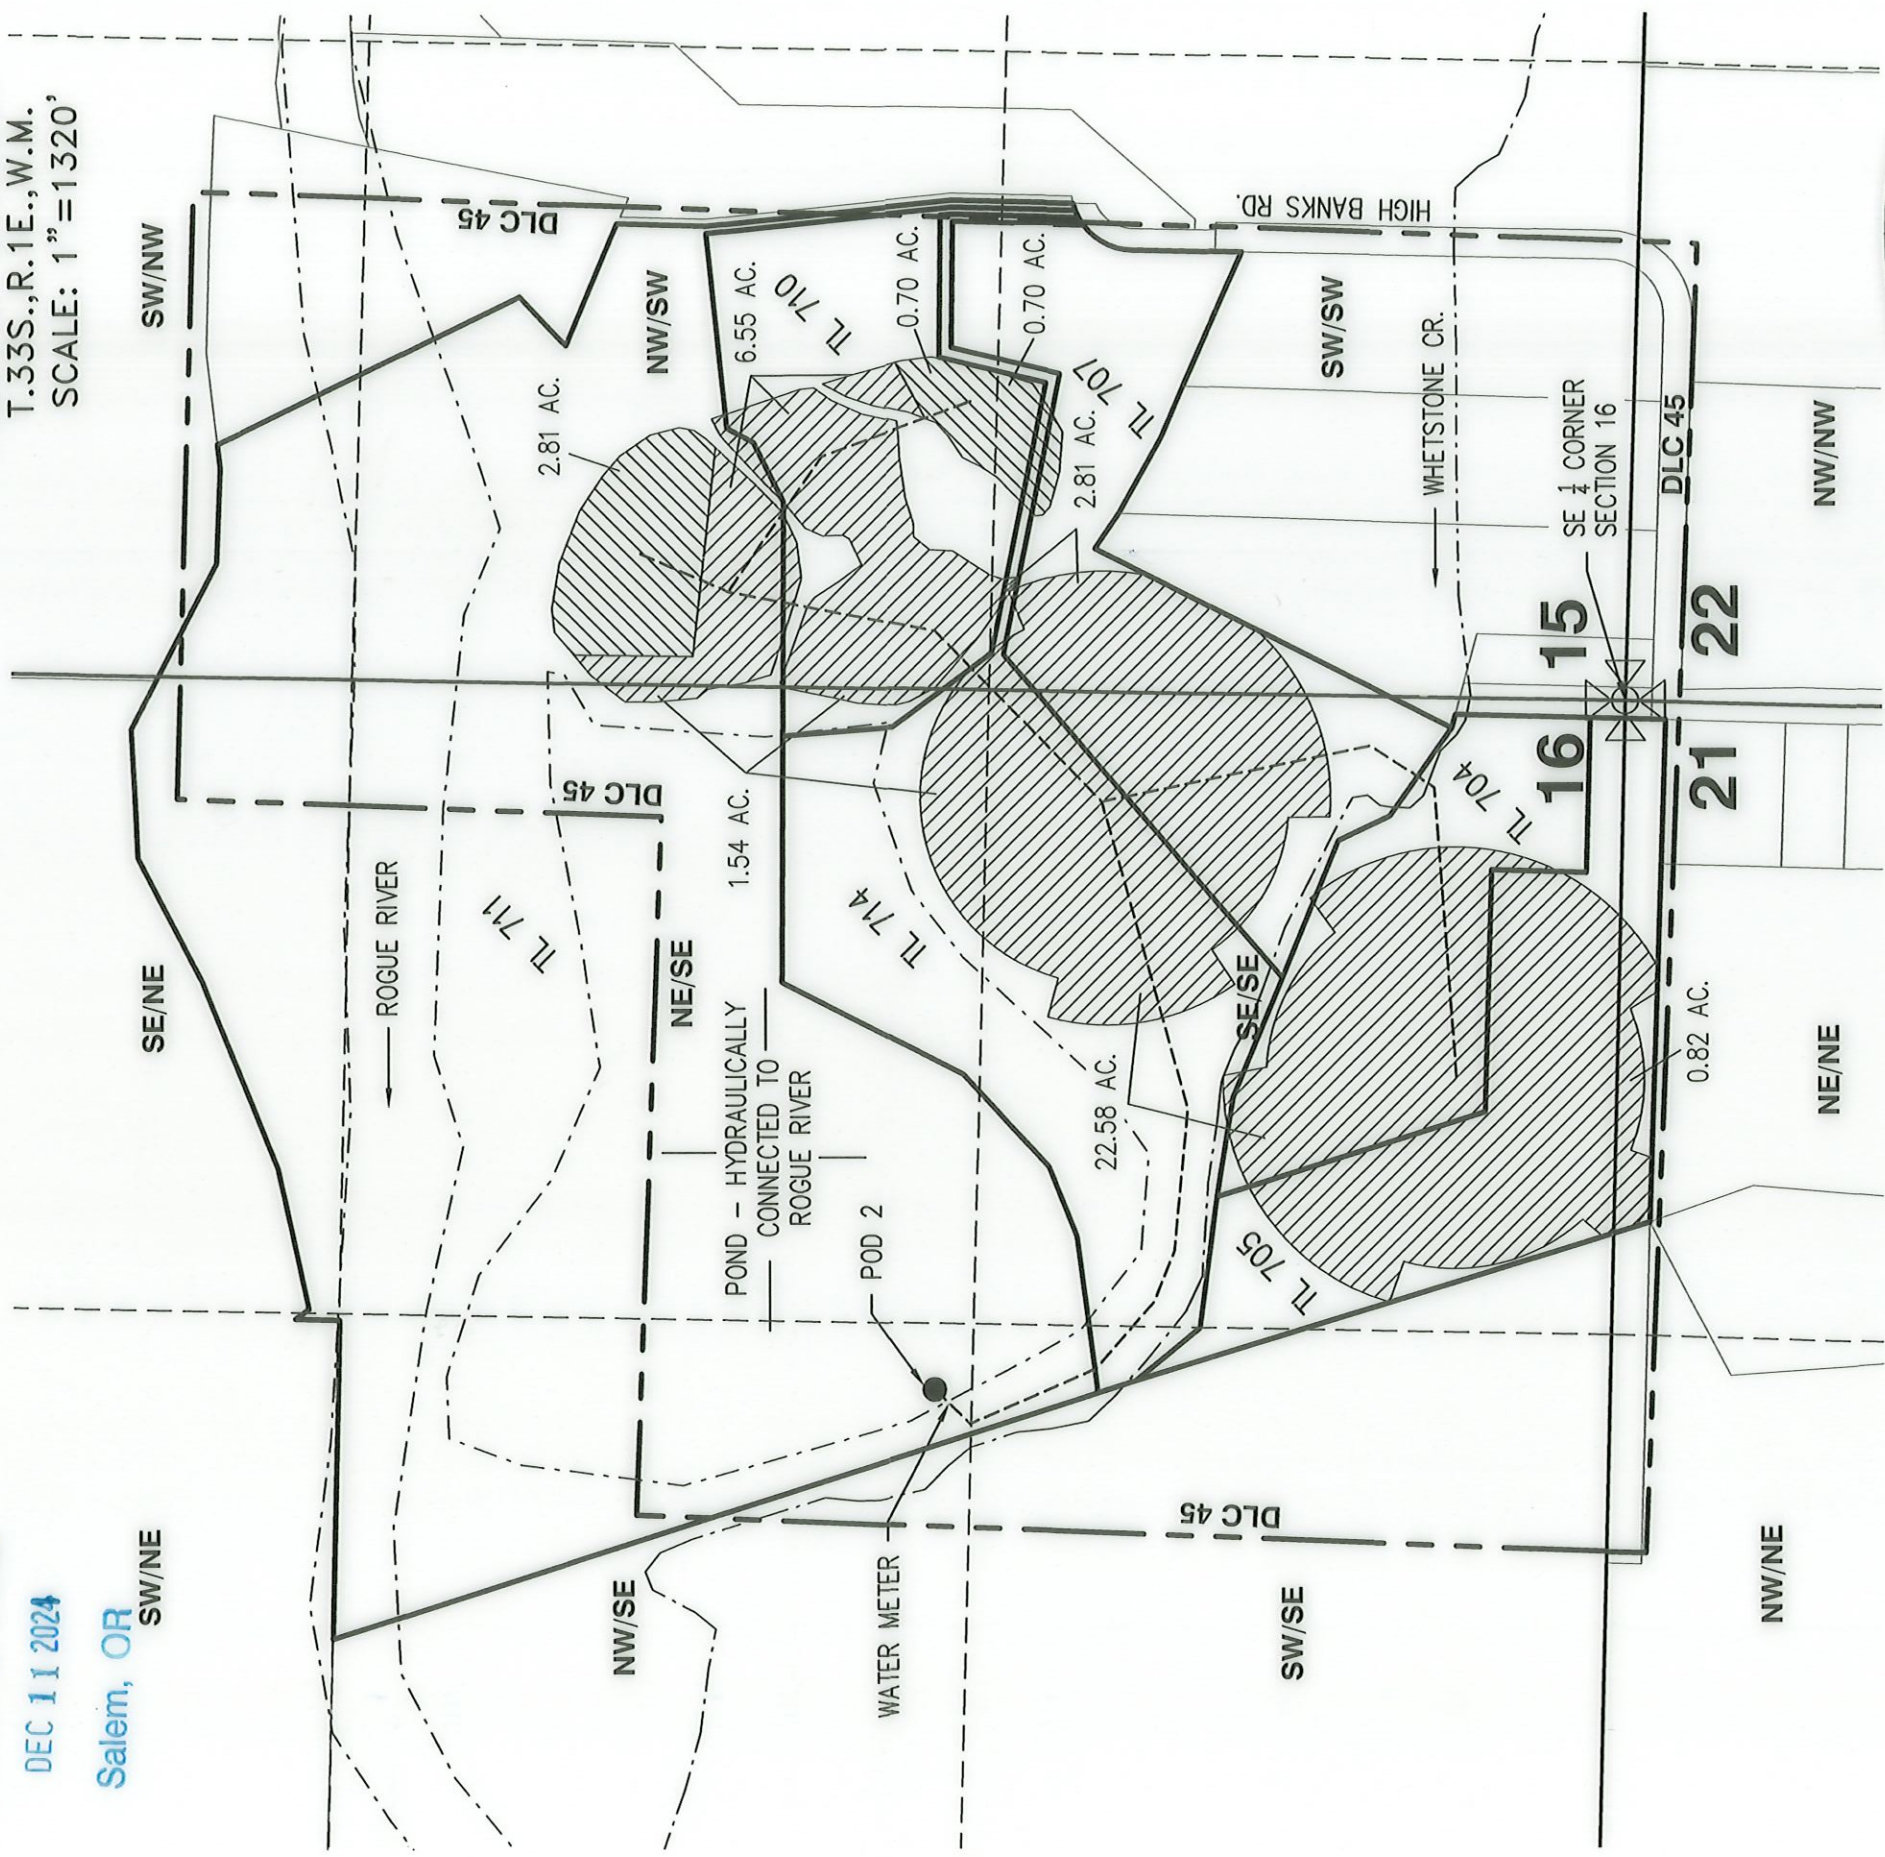

LEGEND

- **POD 2**
POINT OF RE-DIVERSION AND PUMP
1442' NORTH AND 1429' WEST
OF SE 1/4 CORNER SECTION 16
- PLACE OF USE
PRIMARY IRRIGATION
- PLACE OF USE
SUPPLEMENTAL IRRIGATION
- 1/4-1/4
- SECTION LINE
- WATERLINE
(APPROXIMATE)
- EDGE OF SURFACE
WATER
(APPROXIMATE)

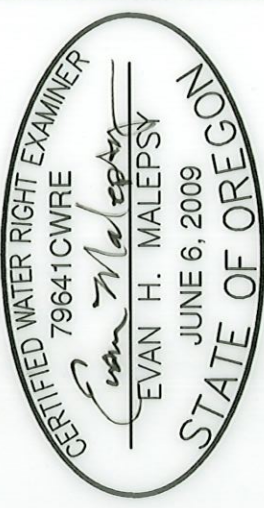

RENEWALS: 12/31/2024
This map is not intended to
provide legal dimensions or
locations of property
ownership lines.

EHM-September 11, 2024
ROGUE CIVIL LLC
emalepsy@roguecivil.com 541-621-2868