


# Claim of Beneficial Use - Wand

## Application S-70924, Permit S-51507

Township 7S, Range 11W, W.M.

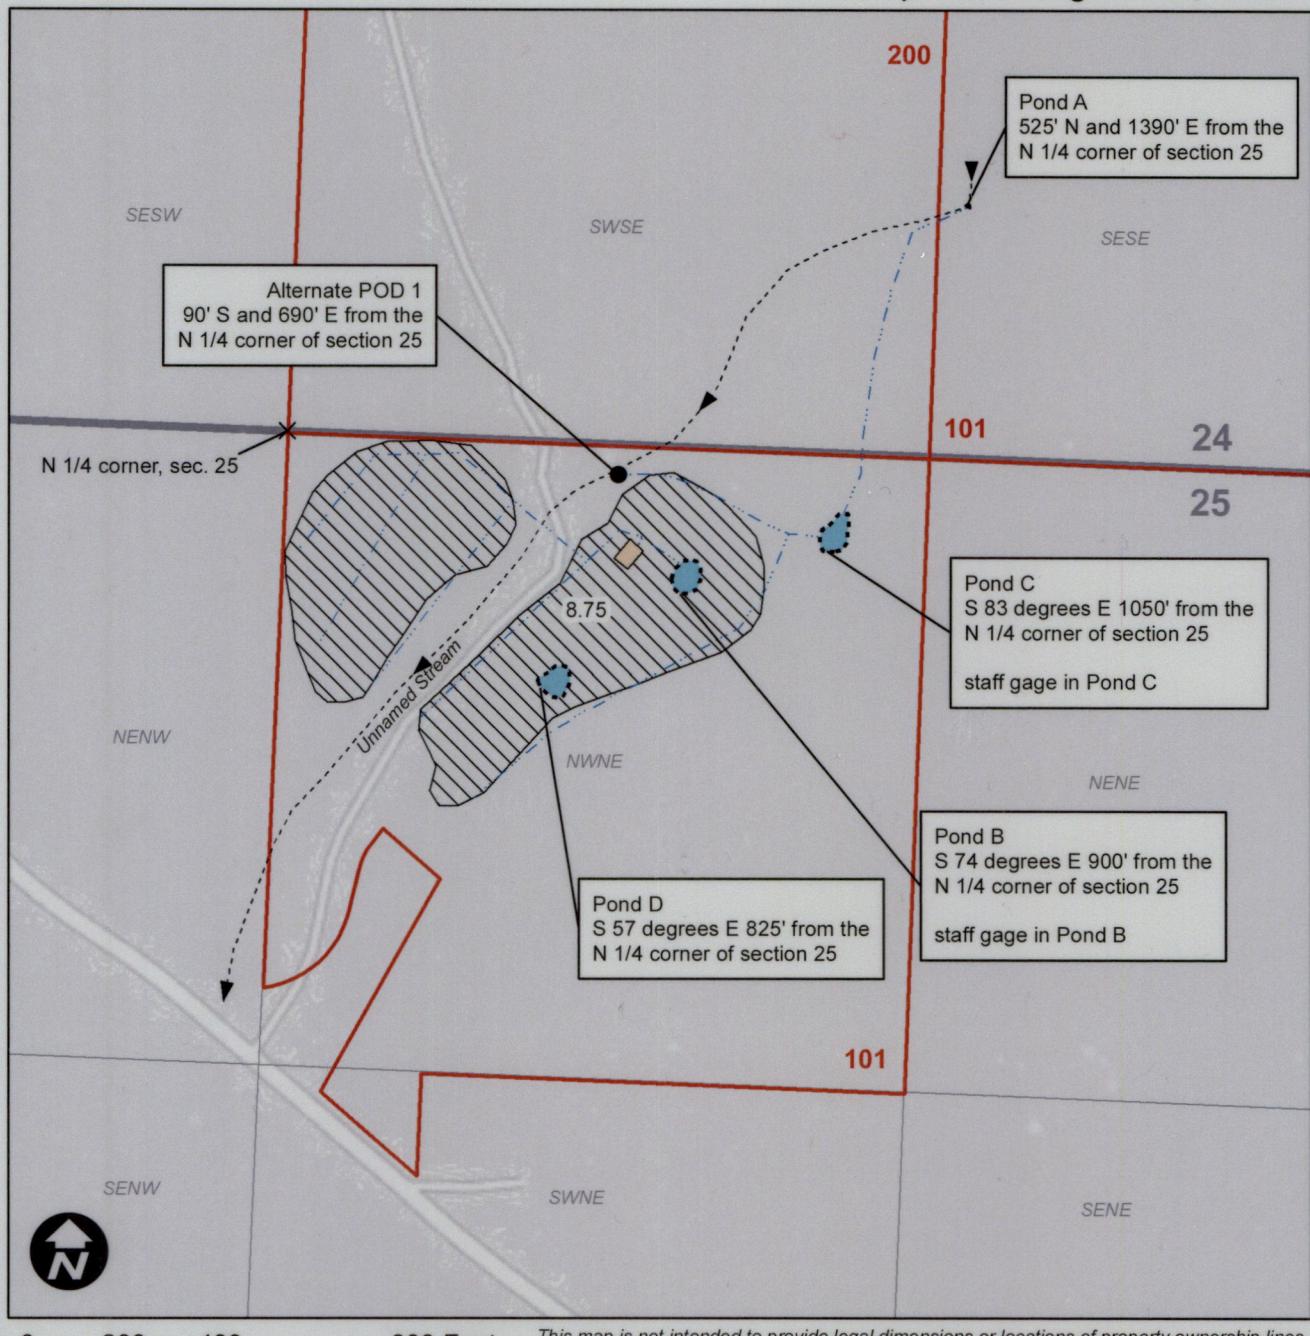

0 200 400 800 Feet

This map is not intended to provide legal dimensions or locations of property ownership lines.

### Legend

- |       |          |  |         |
|-------|----------|--|---------|
|       | IR POU   |  | House   |
|       | Ponds    |  | Taxlots |
| ----- | Pipeline |  |         |

Received by OWRD

DEC 11 2024

Salem, OR

