


OW RD! WATER Application
S-89842

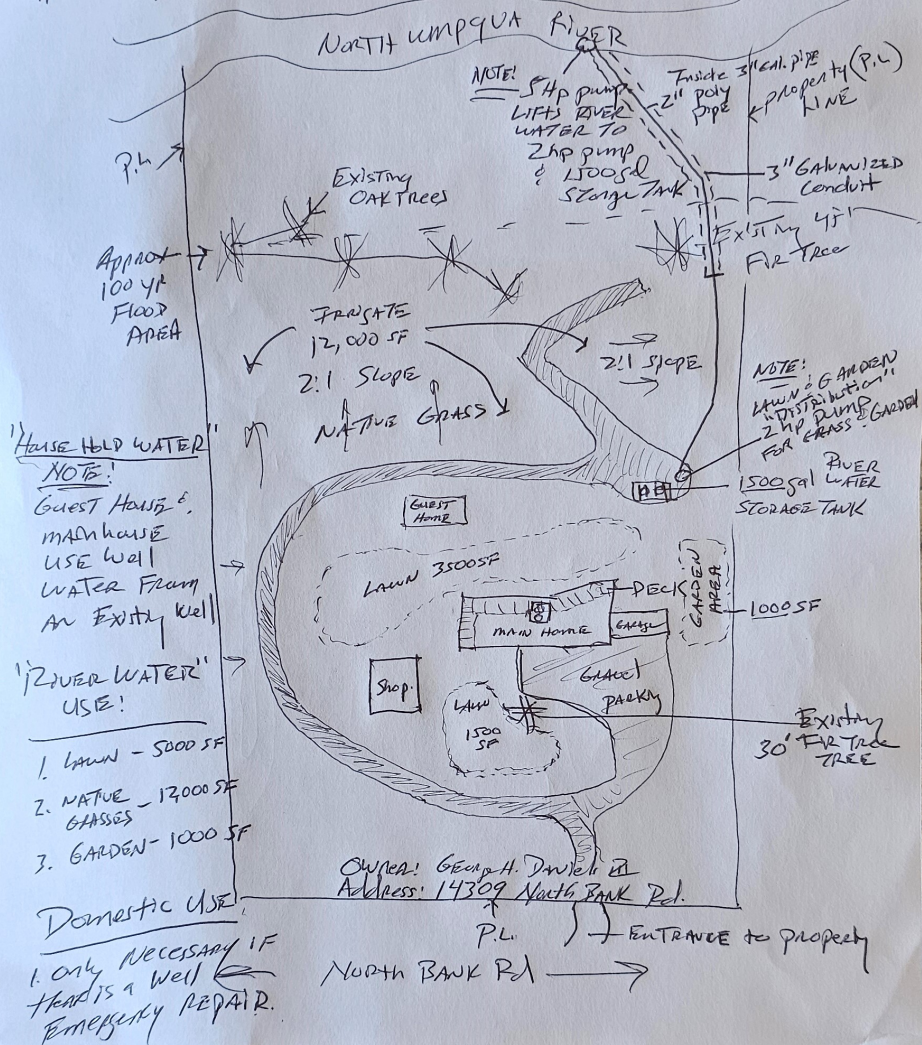

OWRD