


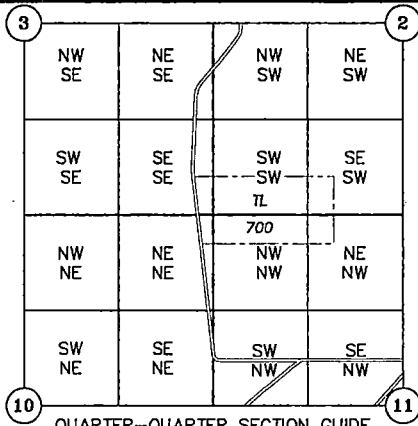


QUARTER-QUARTER SECTION GUIDE

NTS

T5S, R5W, WM

YAMHILL COUNTY

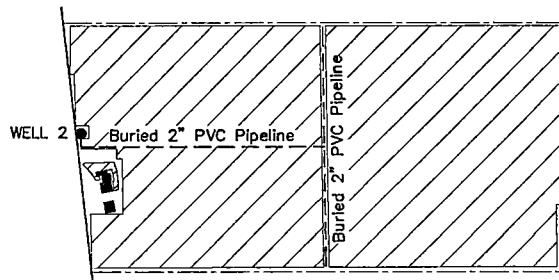


PIPELINE DETAIL

1" = 600'

TAX LOT:
5.5.02 700

- DLC LINE
- TAX LOT LINE
- PIPELINE
- BUILDING
- WELL POA w/METER IN ADJACENT SMALL BUILDING

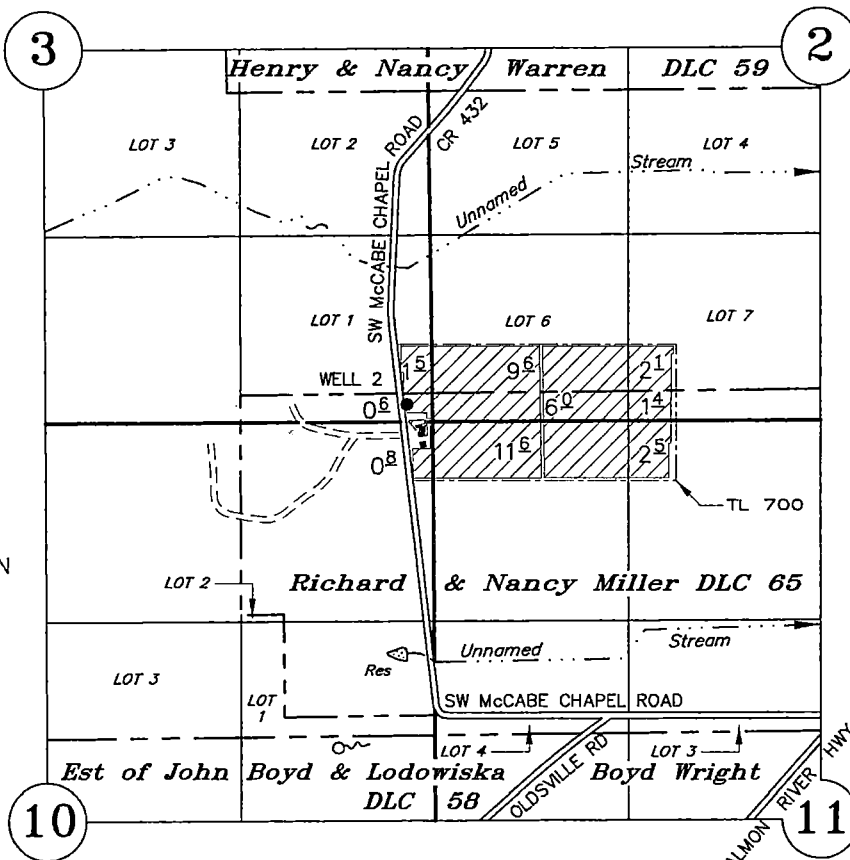

WELL 2: 62' SOUTH & 1142' EAST OF NW COR MILLER DLC No. 65
METER: 62' SOUTH & 1154' EAST OF NW COR MILLER DLC No. 65

Received by OWRD

DEC 13 2024

Salem, OR

CLAIM OF BENEFICIAL USE

UNDER


Application No. G-17498

Permit No. G-17594

Lillian & Arthur Frease

JANUARY 13, 2023

SCALE 1" = 1320'

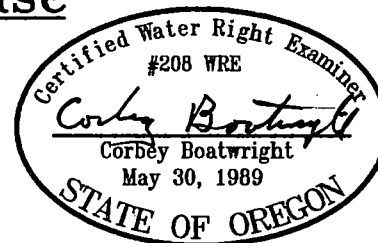

Renewal Date: December 31, 2025

NOTE: This map is not intended to provide legal dimensions or locations of property ownership lines.