


Received by OWRD

TOWNSHIP 16 SOUTH, RANGE 5 WEST, W.M.

DEC 13 2024

Salem, OR

TL1300

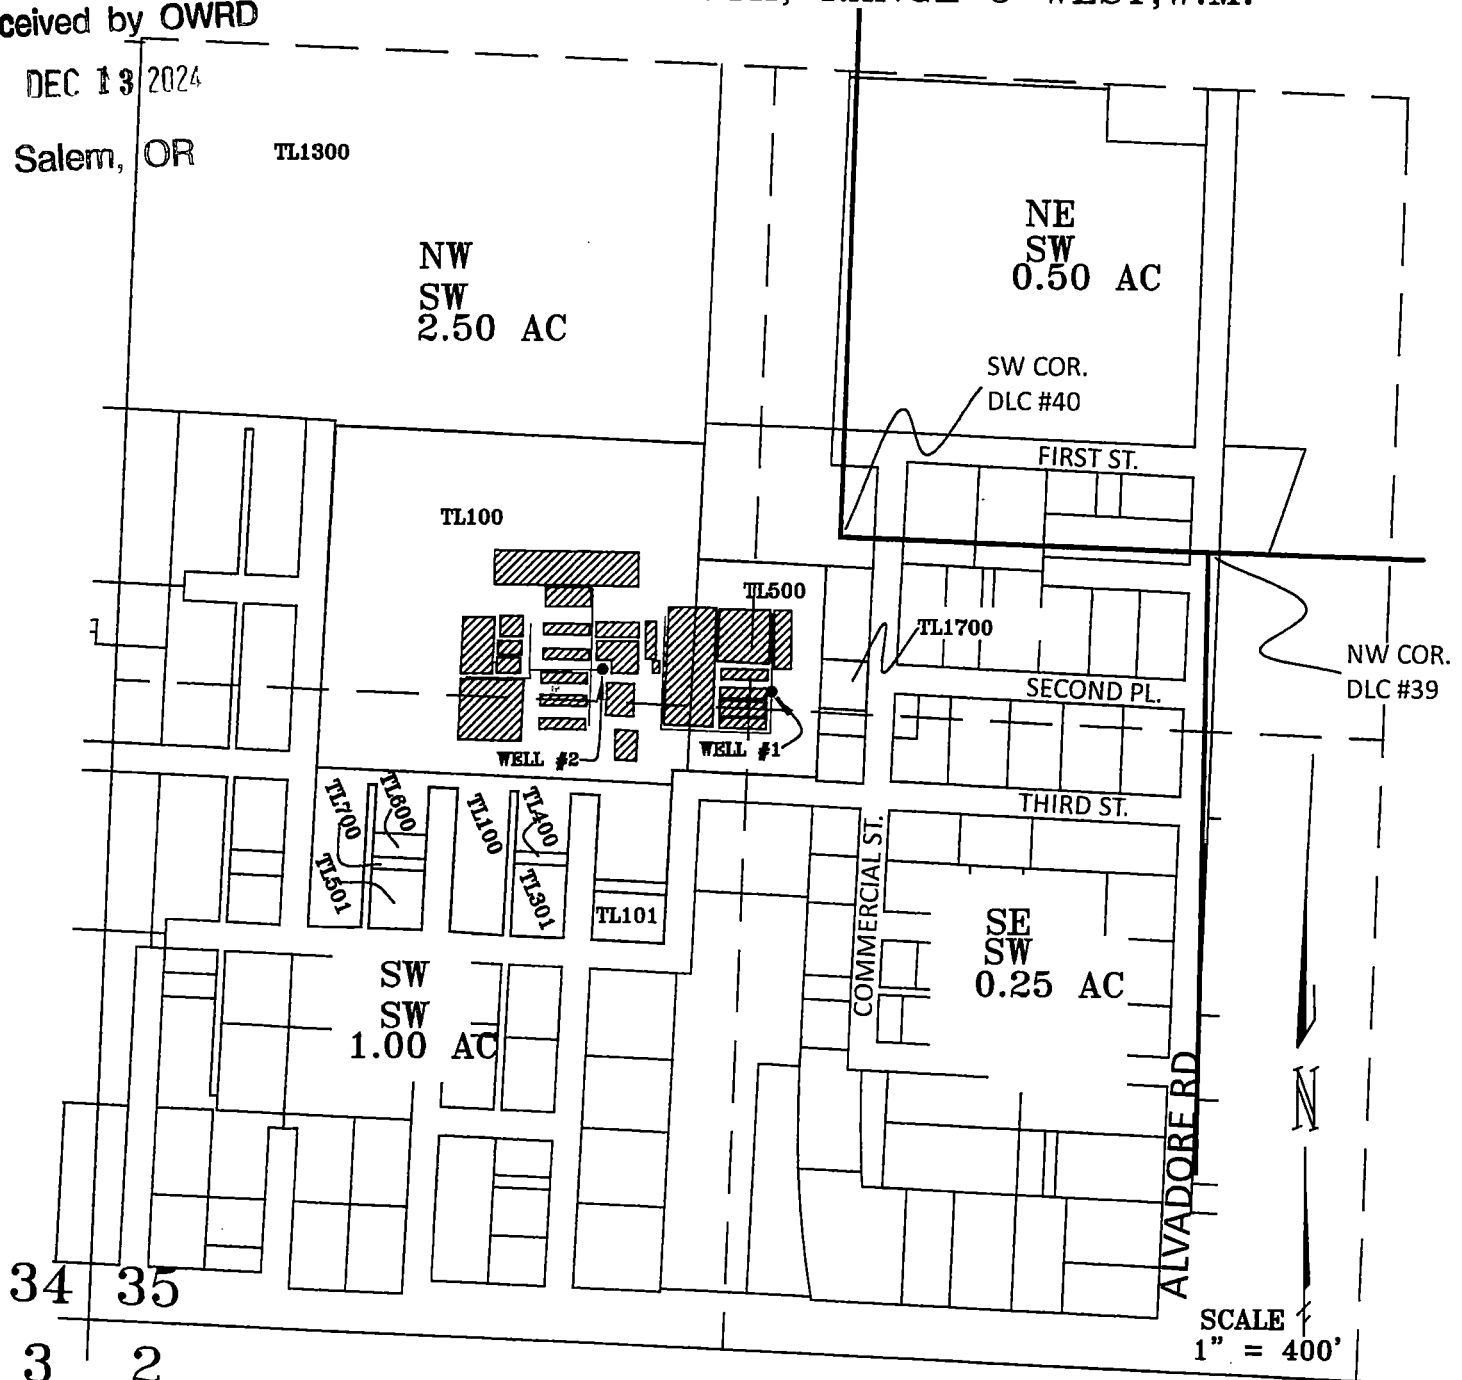

 DENOTES AREA OF BENEFICIAL USE


WELL #1 LOCATION
910 FEET WEST & 297 FEET SOUTH
NW COR. DLC #39

WELL #2 LOCATION
1282 FEET WEST & 253 FEET SOUTH
NW COR. DLC #39

— DENOTES BURIED MAINLINE LOCATION

NOTE

THIS MAP WAS PREPARED FOR THE PURPOSE OF IDENTIFYING THE LOCATION OF THE WATER RIGHT ONLY. IT IS NOT INTENDED TO PROVIDE DIMENSIONS OR LOCATION OF PROPERTY OWNERSHIP LINES.

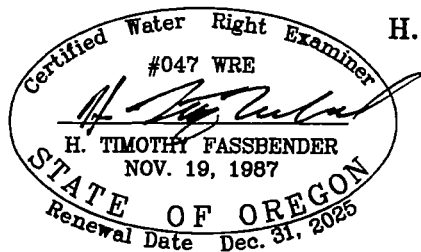

APPLICATION G-18225 PERMIT G-17840
CLAIM OF BENEFICIAL USE MAP

FOR
D & B FARMS, LLC
PO BOX 567
EUGENE, OR. 97410
541-228-8388

BY
H. TIMOTHY FASSBENDER, PLS, CWRE
2896 SARAH LN
EUGENE, OR. 97408
541-485-3136
NOVEMBER 14, 2024