
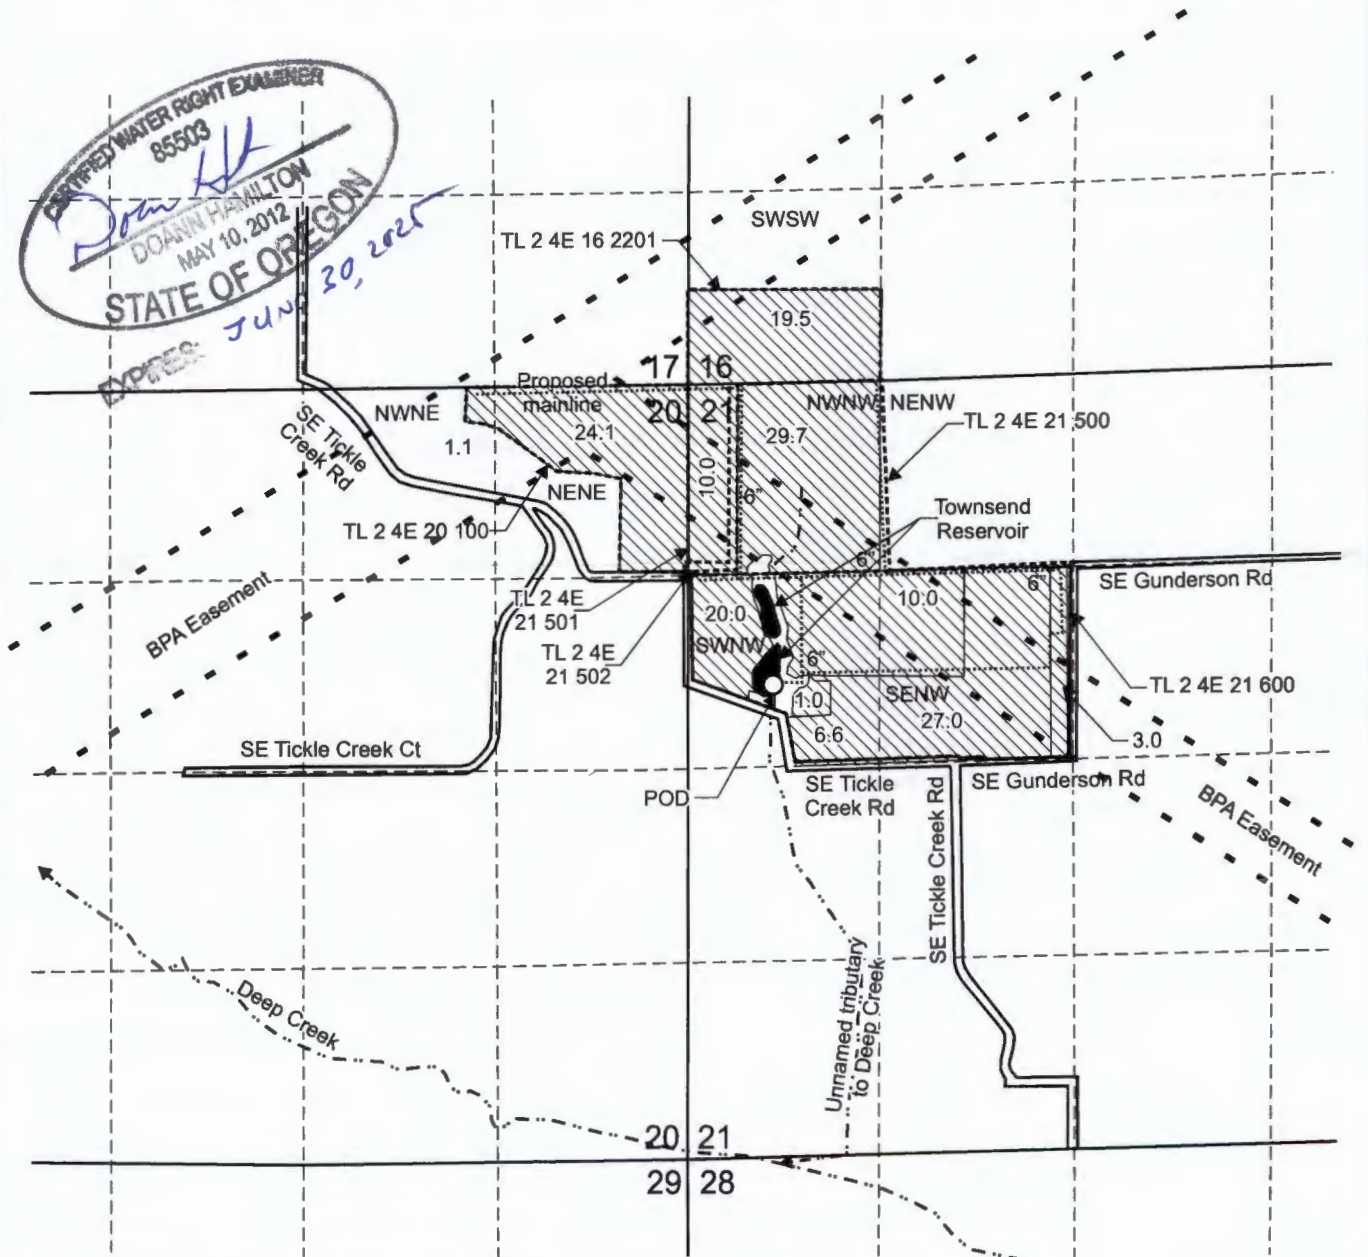


T.2S. R.4E. Sec. 16, 20 & 21, W.M.

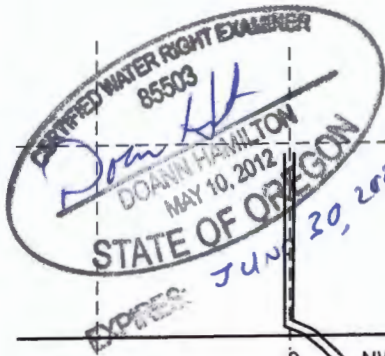


POD is located 2,055 feet south and 580 feet east from the NW corner, Section 21.

Area (152.0Acres) to be irrigated using 8.6 AF from Permit R-15344.

----- Tax lot boundary Water main line

Scale: 1" = 1,320'

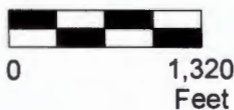

Received
DEC 18 2024

OWRD

This map was prepared for the purpose of identifying the location of a water right only and is not intended to provide legal dimensions or location of property ownership lines.

Surface Water Application Map

Pacific Hydro-Geology Inc.

11/2024

Townsend Farms LLC
T.2S. R.4EW. Sec. 16, 20 & 21, W.M.