


LEGEND


- ⊙ Point of Appropriation (POA)
- ▨ Place of Use (POU)
- Property Lines
- ~ Streams
- Conveyance Mains

POD Location Description

Tualatin River POD Located 900 feet South and 650 feet West from the center of Section 18 (NESW), Township 2 South, Range 1 West, W.M.

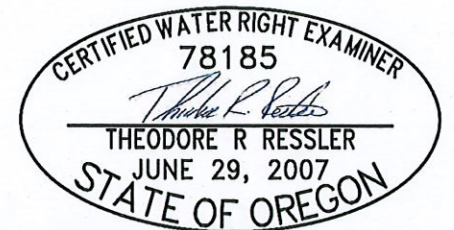

RENEWS: 12.31.2024

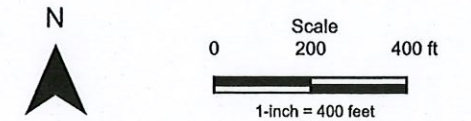

Date: 7/18/2023
 Data Sources: BLM, OWRD, USGS, Washington County
 Disclaimer: This map is not intended to provide legal dimensions or property ownership lines.

Claim of Beneficial Use
 Permit S-51982, Application S-73365

A Water Right held by AGC properties, LLC
 Washington County

Received
 DEC 20 2024

