


Map For Claim of Beneficial Use

Section , T4S, R3W, Polk County
Transfer T-14184

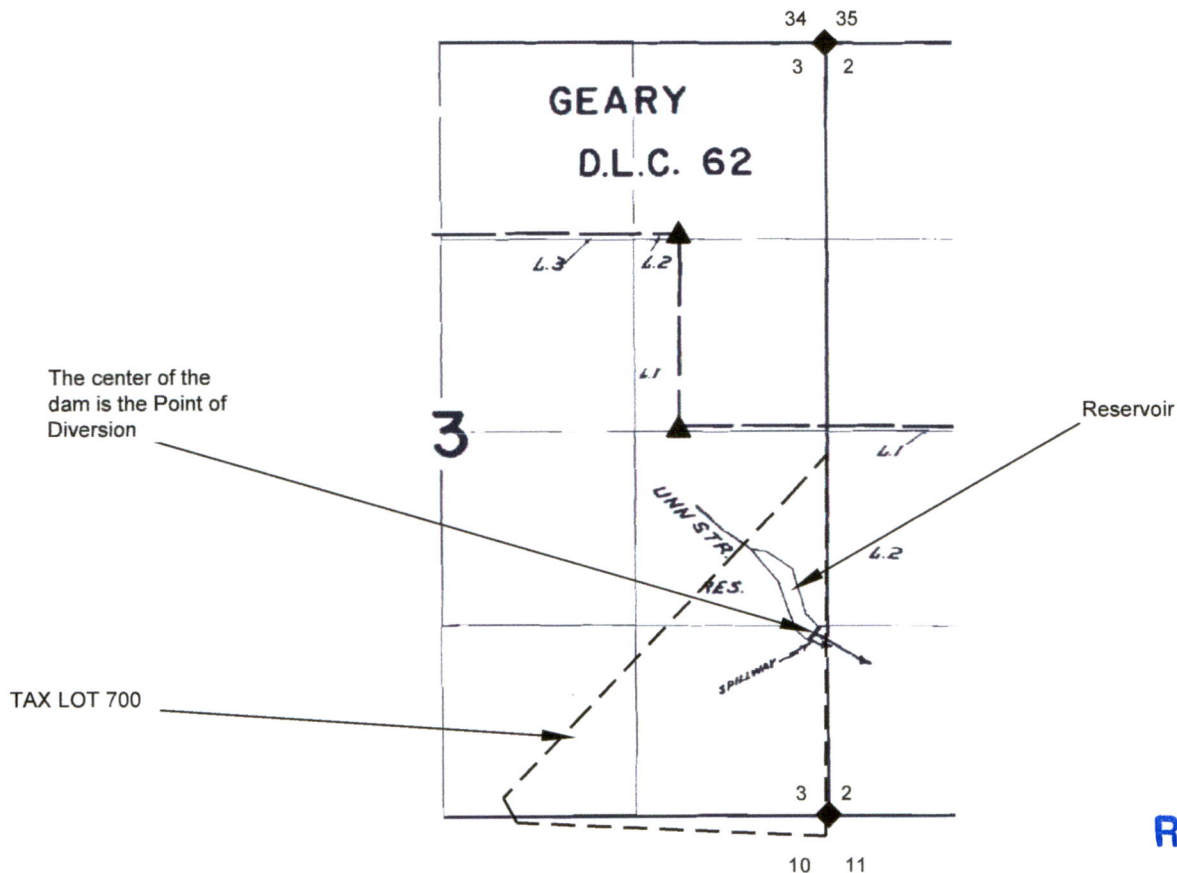

1 IN = 1320 FT
0 660 1320




Received
DEC 23 2024
OWRD

NOTES:

- THIS MAP IS NOT INTENDED TO PROVIDE LEGAL DIMENSIONS OR LOCATIONS OF PROPERTY OWNERSHIP LINES.
- THIS MAP USES THE MAP FOR CERTIFICATE 33785 AT ITS BASIS. THE SECTION AND QUARTER-QUARTER LINES AND RESERVOIR ARE BASED ON THE CERTIFICATE MAP FOR CERTIFICATE 33785.
- THE PROPERTY LINES IS BASED ON A TAX ASSESSOR MAP.
- WATER CONVEYANCE LINES SHALL BE ALL WITHIN THE PROPERTY AND THEREFORE ARE NOT SHOWN.

LEGEND

- ▲ DONATION LAND CLAIM (DLC) CORNER
- ◆ SECTION CORNER
- > — STREAM OR SURFACE DRAINAGE
- - - TAX LOT LINE
- SECTION LINE

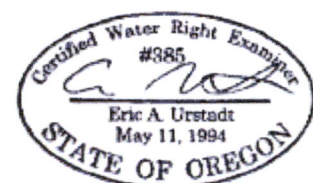

Exp. 30 JUN 2024

MAP BY:
**ASPEN RURAL LAND
CONSULTING**
ERIC URSTADT, PE, PLS
971-250-1520
OCT 2024
WWL-DickPaine3B