

Name E. W. BRUTHA

By _____

Address ROUTE 1, BOX 65C
BROOKS

MARION COUNTY

Date filed FEBRUARY 19, 1958 11³⁰ AM

Tentative priority May 1938 or - May 1951

Action suspended until _____

Well log filed _____

CONSTRUCTION

Date for completion _____

Extended to _____

Date for application of water _____

Extended to _____

PROSECUTION OF WORK

Form "B" filed _____

Form "C" filed _____

Application No. GR 1045

Certificate No. GR 1007

Stream Index, Page No. 2-92R

FEEES PAID

Date	Amount	Receipt No.
2/19/58	15-	15182
_____	_____	_____
_____	_____	_____

FEEES REFUNDED

Date	Amount	Check No.
_____	_____	_____

ASSIGNMENTS

Date	To Whom	Address	Volume	Page
_____	_____	_____	_____	_____
_____	_____	_____	_____	_____

REMARKS

A well irrigates 10² acres near (Marion Co) Little Pudding River

August 23, 1991

Rosella P. Brutka
5470 Brookdale Road NE
Brooks OR 97305

USER-ID: 9550

Dear Mrs. Brutka,

With regard to the pump test requirements for the following well and its associated water right:

POD-ID	Well	Application	Permit	Certificate	Status
19702	Well 1	GR-1045	GR-1007	0	Approved

The Water Resources Department has reviewed and accepted the pump test results you submitted. The Department requires no further testing of this well at this time. However, you will be required to submit a static water level measurement of the well on the ten-year anniversary of the test you conducted.

We appreciate your cooperation in this program. If you have any questions, please contact Bill Ferber at the address below or by calling 378-8455.

Sincerely,

Sam Allison
For

FRED LISSNER, Manager
Groundwater/Hydrology Section

cc: Water Rights Section




SECTION

TOWNSHIP 65, RANGE 2W, W. M.

North

West

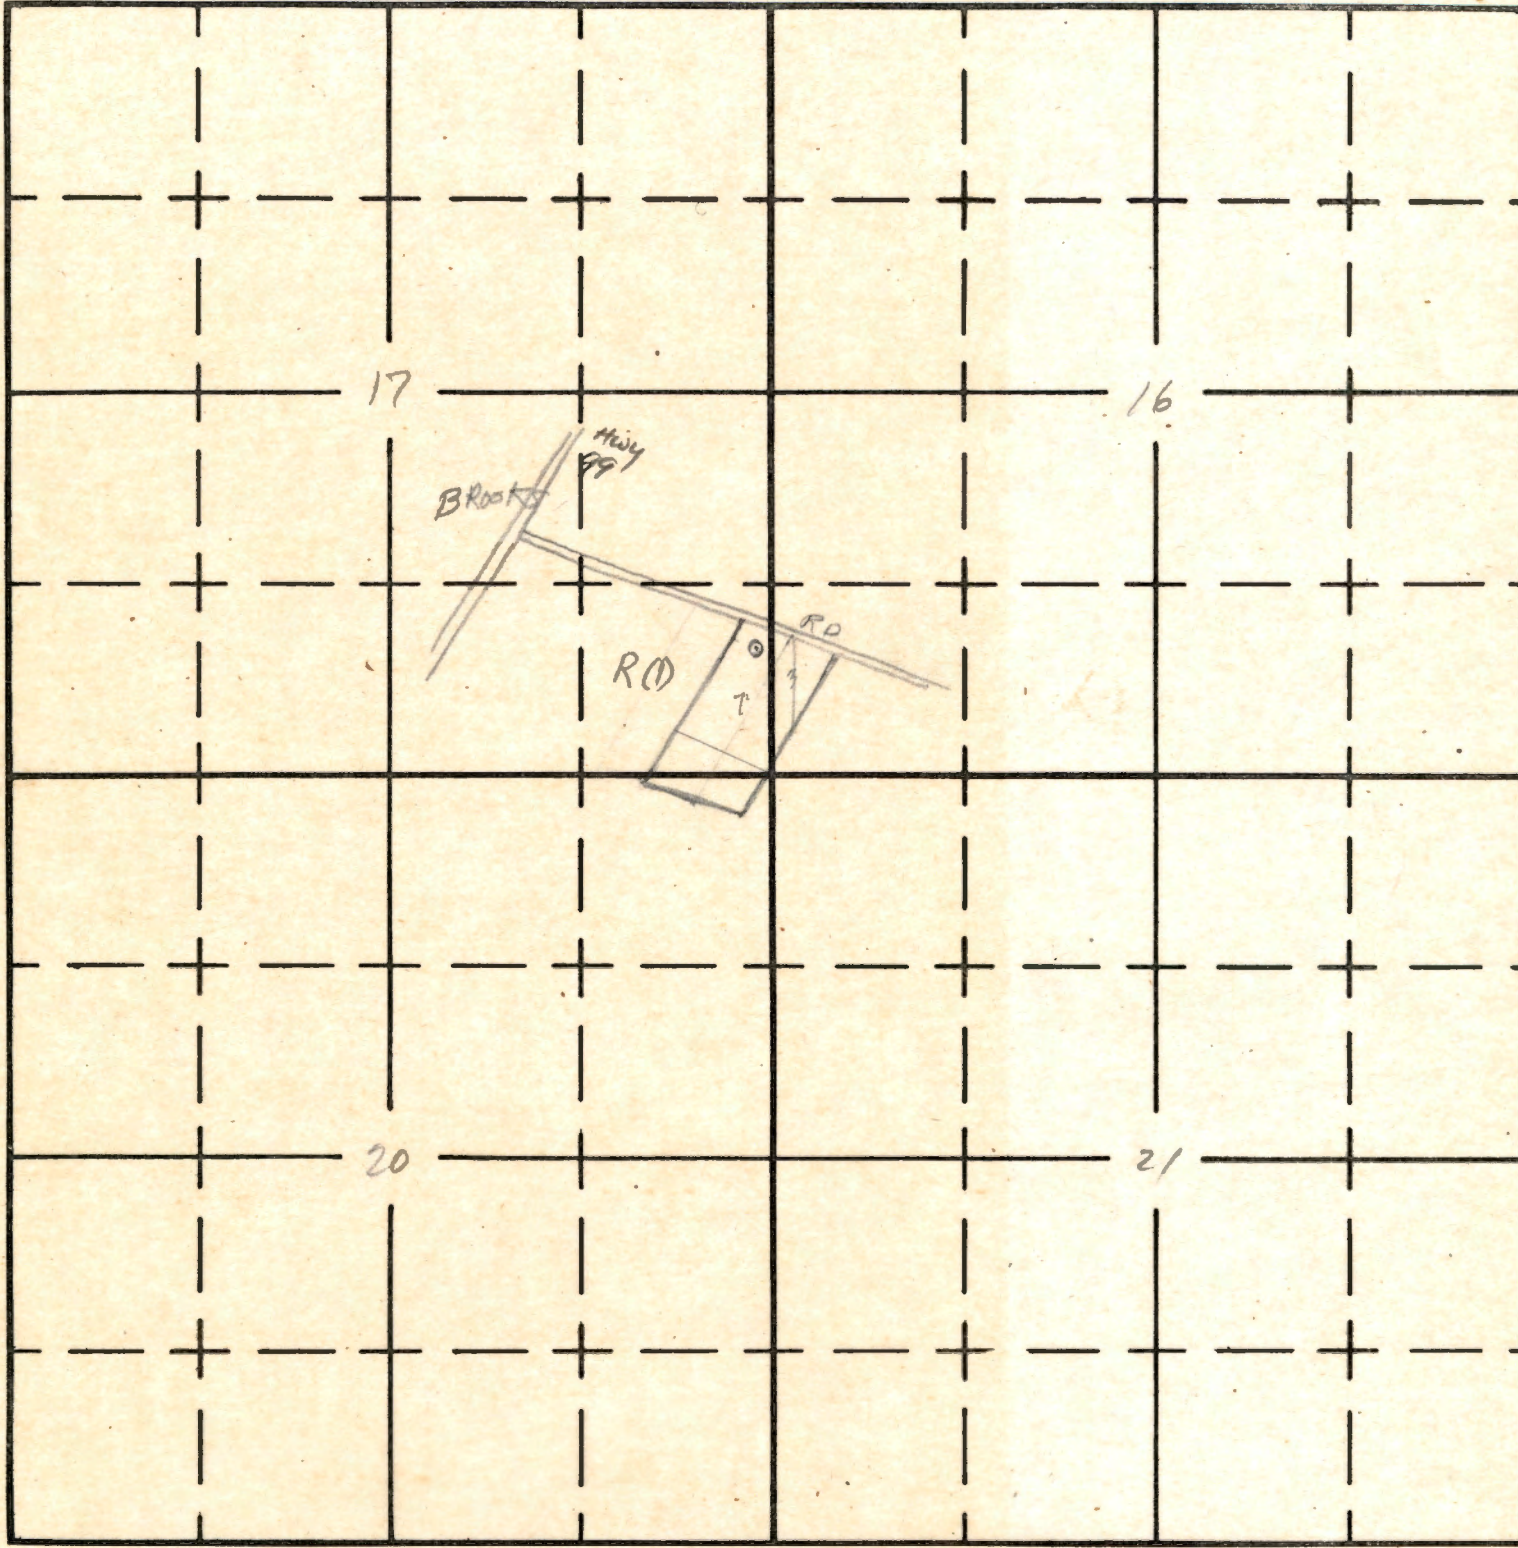

South

GR 1045

GR-1045

July 17, 1958

Mr. E. W. Brutha
Rt. 1, Box 65 C
Brooks, Oregon

Dear Mr. Brutha:

GR-1045
GR-1007