




KATHERINE HU
29 W SOUTHERN AVE
TEMPE, AZ 85282

CLAIM OF BENEFICIAL USE
R-14133 (APPL. NO. R-85902)

SITUATED IN
SECTIONS 8 & 9
TOWNSHIP 33 S RANGE 5 W, W.M.
JOSEPHINE COUNTY OREGON

LEGEND

- SINGER LAKE POD
600' NORTH and 790' EAST
OF SW 1/4 CORNER
SECTION 9 T33S R5W
- OUTLET PIPES AND
SPILLWAY
650' NORTH and 645' EAST
OF SW 1/4 CORNER
SECTION 9 T33S R5W
- △ INLET PIPE

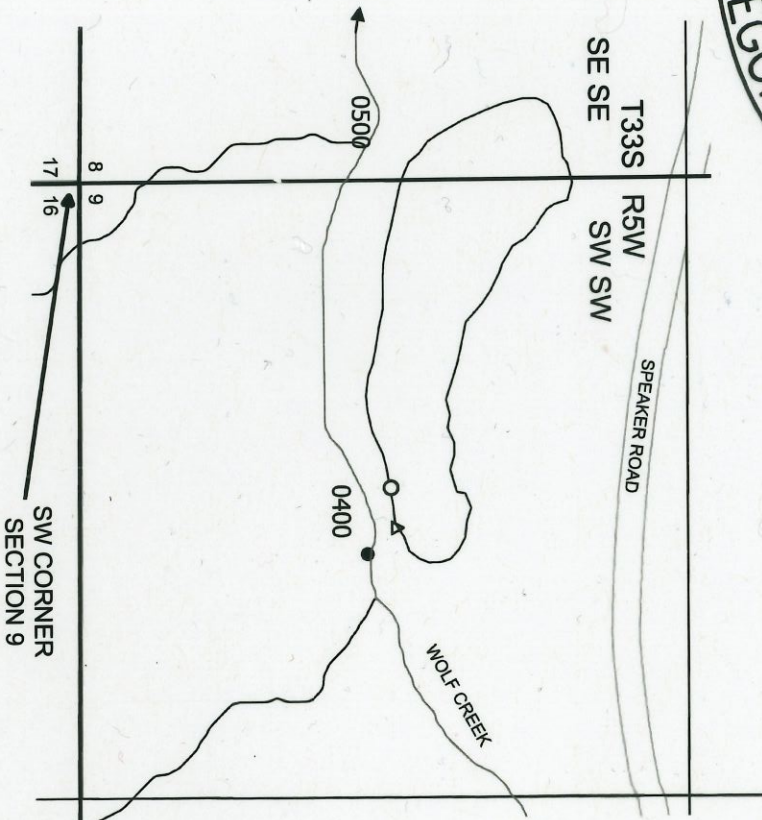

0 400 ft

This map is not intended to provide
legal dimensions or locations of
property ownership lines

ParsonsWater Consulting LLC
rick.parsons@parsonswater.com
541.499.0257 303.667.5067

Received
DEC 21 2021
OWRD