


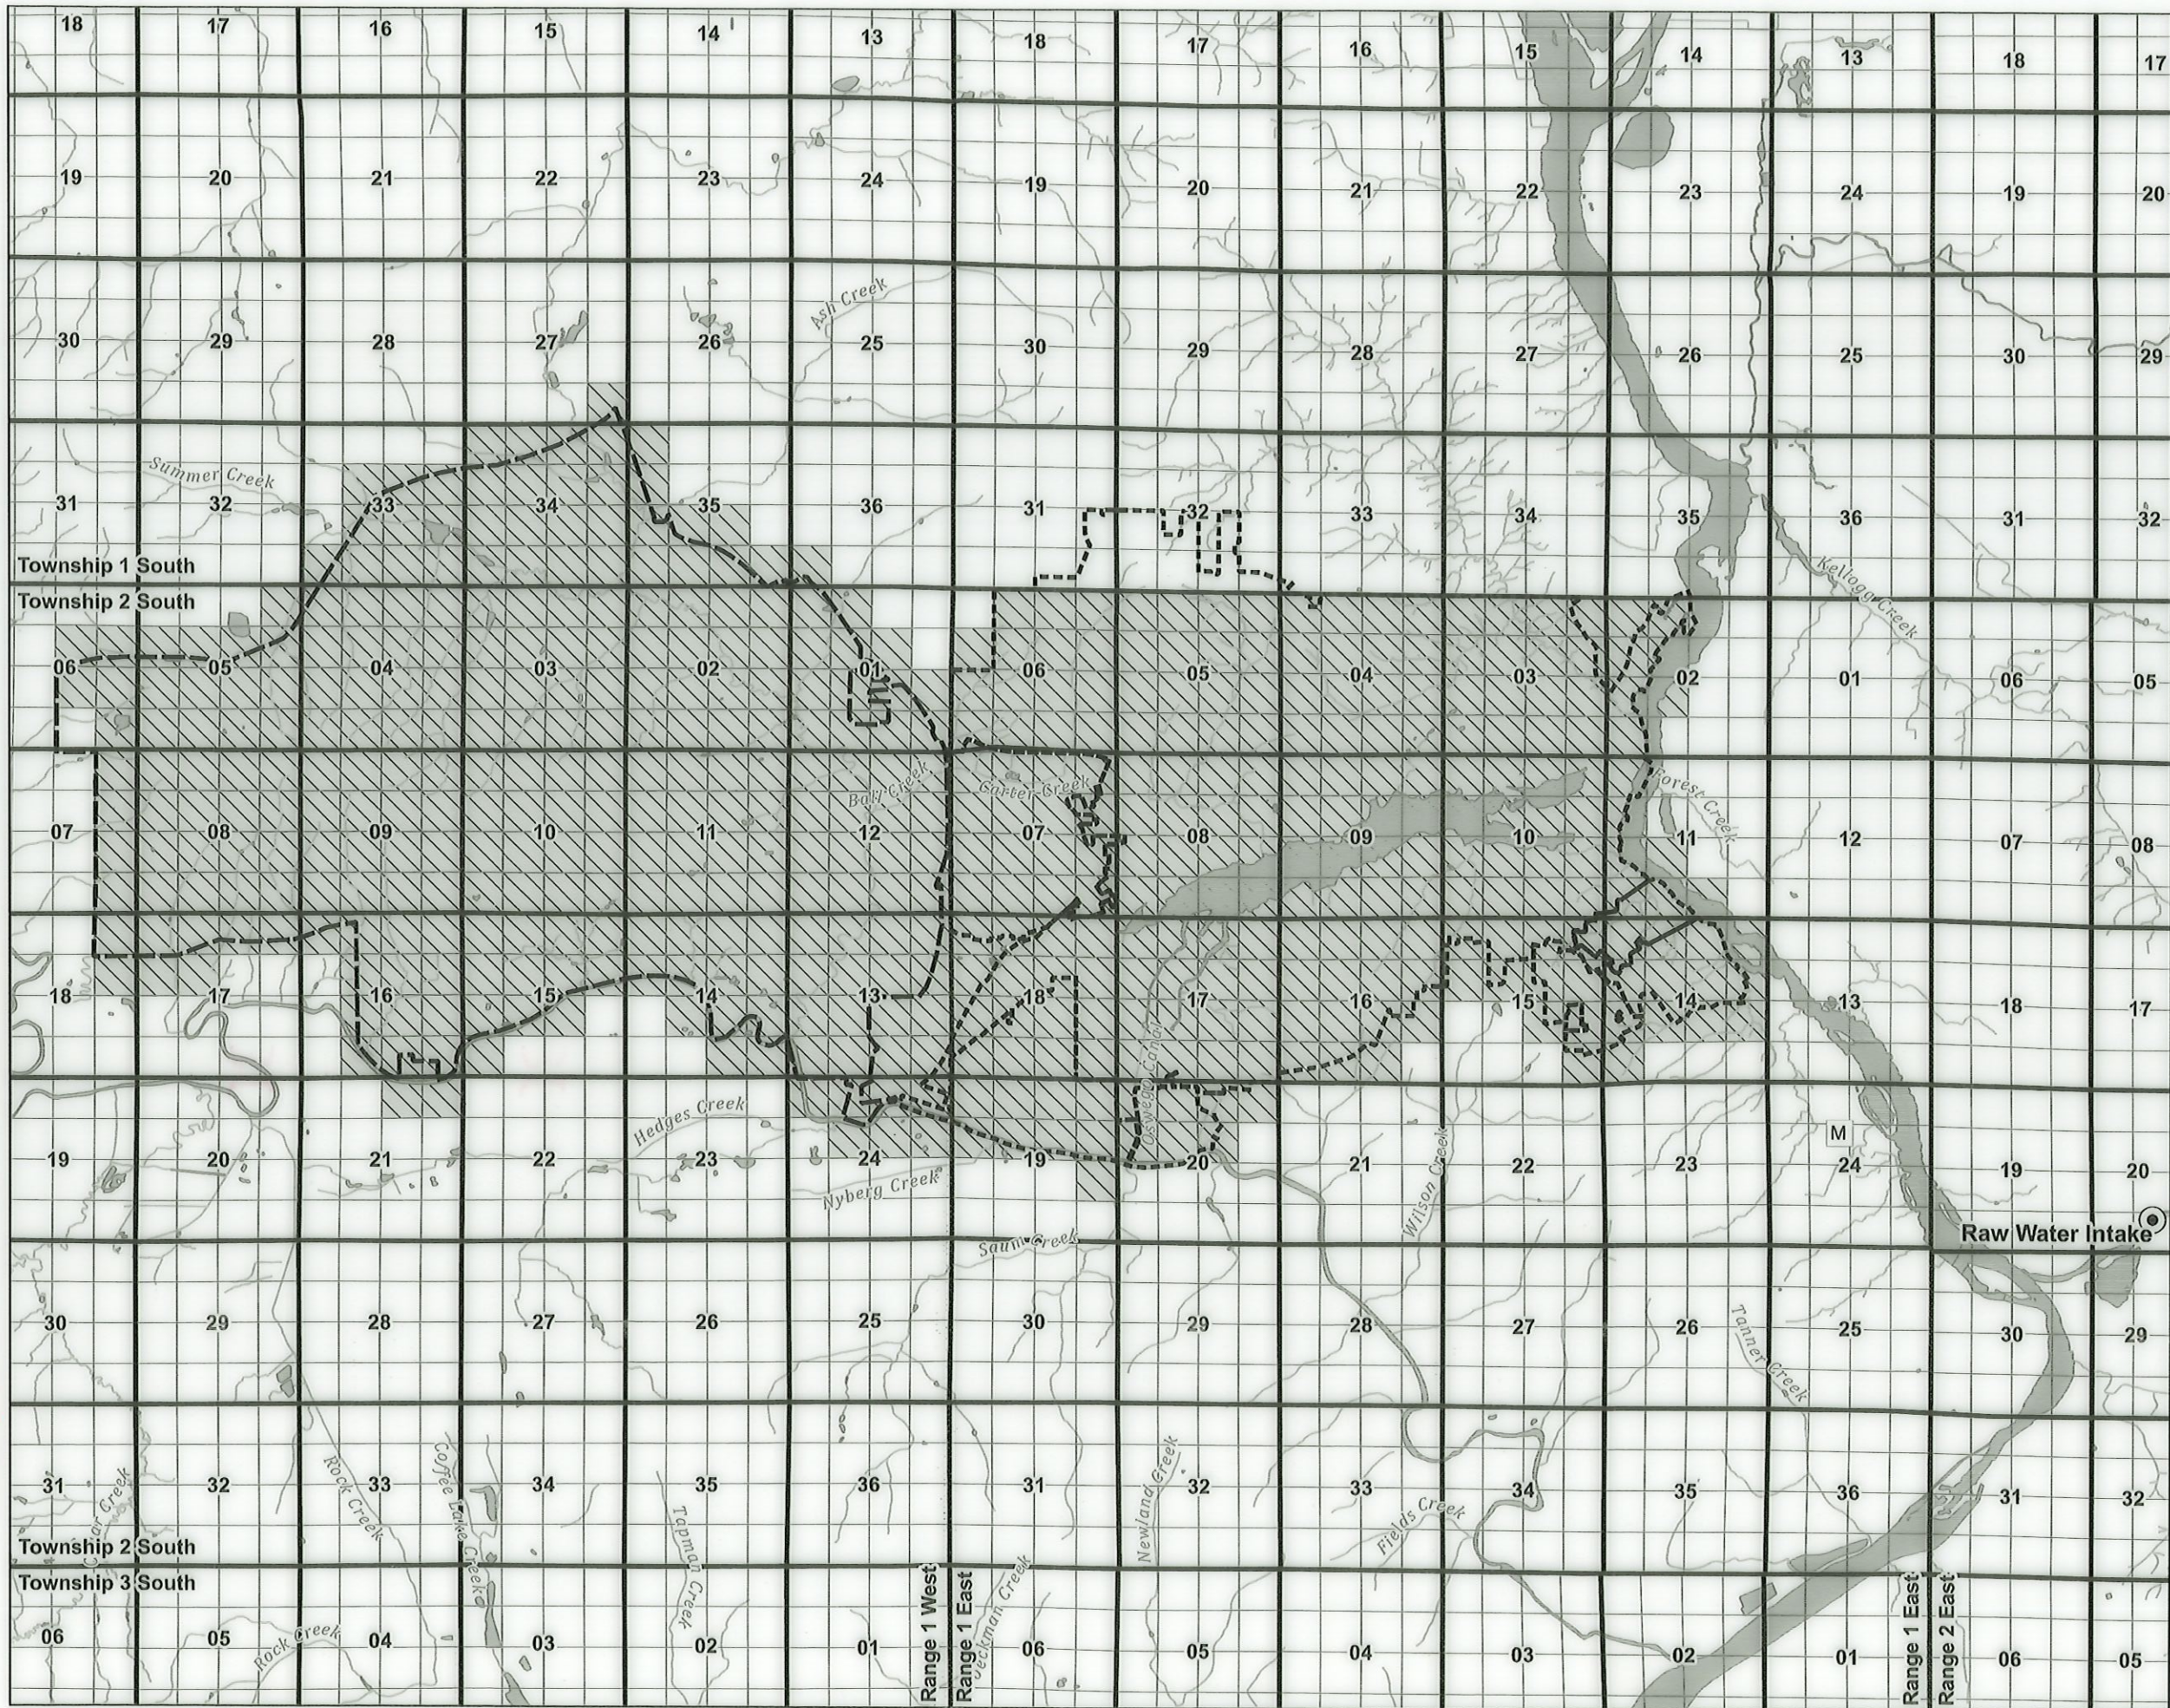

- LEGEND**
- Point of Diversion (POD)
 - M Raw Water Flow Meter
 - ▨ Place of Use (POU)
 - Watercourses
 - Water Service Area Boundary
 - City of Lake Oswego
 - City of Tigard



POD Location Description

Raw Water Intake
Located North 60° 20' East 2,200 feet from the SW corner of Section 20 (SESW), Township 2 South, Range 2 East (W.M.)

Map Notes

The Raw Flow Meter is located at the Water Treatment Plant, 4260 Kenthorpe Way, West Linn, Oregon; N45.385351°, W122.631780°

The City provides water within the entire water service area boundary of the City of Lake Oswego and City of Tigard, which includes areas outside of the place of use shown as allowed under ORS 540.510(3).

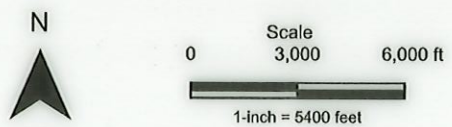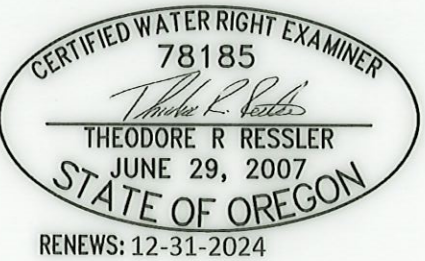

Date: 9/5/2024
Data Sources: BLM, OWRD, OGEO, USGS, ESRI, Washington County, Clackamas County, and METRO.
Disclaimer: This map is not intended to provide legal dimensions or property ownership lines.

**Claim of Beneficial Use
Place of Use Map
Permit S-32410, Application S-43365**

A Water Right in the Name of City of Lake Oswego
Counties of Clackamas, Multnomah, and Washington

Received
DEC 23 2024



COBU MAP # 2130