


CLAIM OF BENEFICIAL USE MAP PERMIT G177998
 LOCATED IN SECTION 29, T40S R2E W.M. TAX LOT 309
 ROGUE RIVER BASIN- JACKSON COUNTY, OREGON

T40S R2E

19 20
 30 29

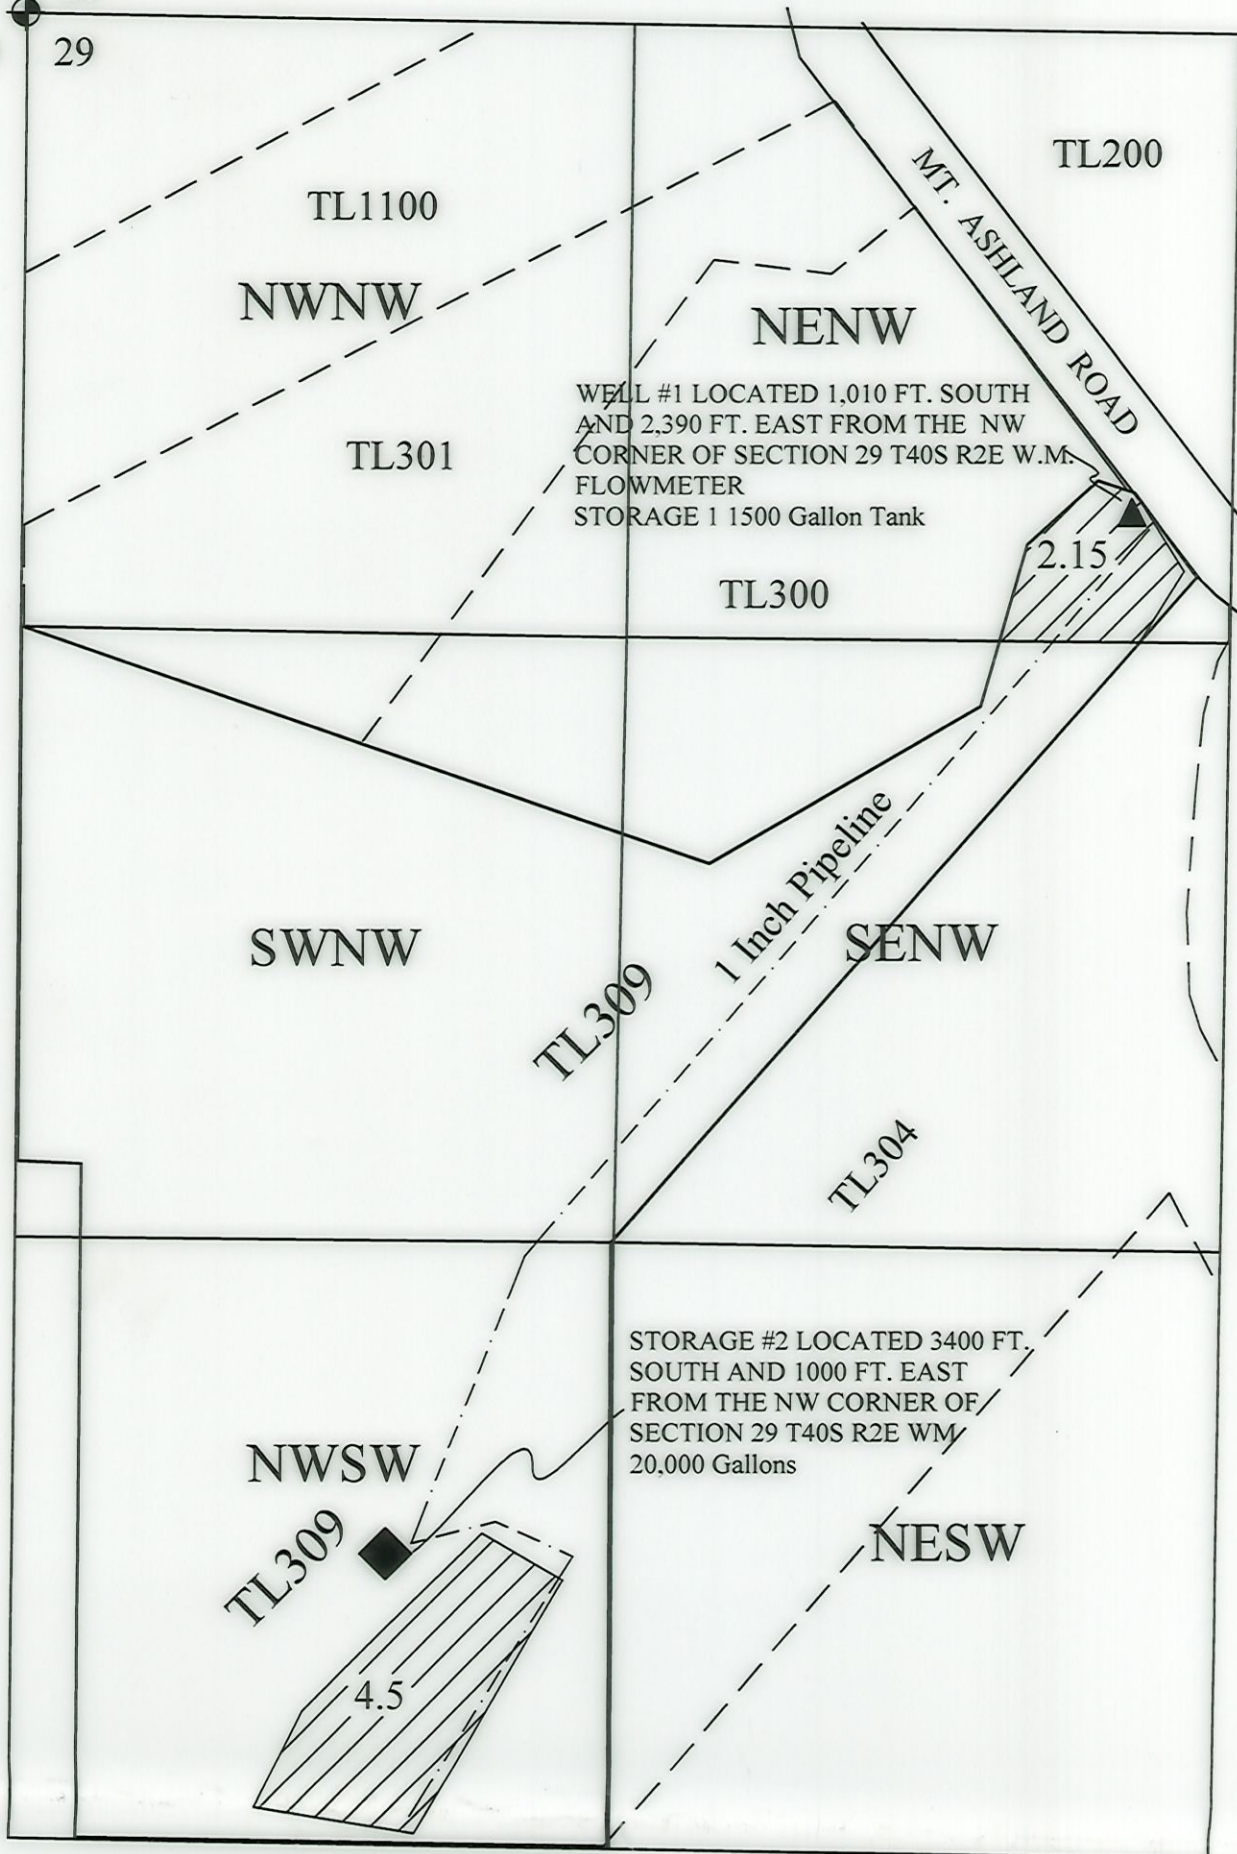

1' = 400'

PREPARED FOR:
 MATT DOLINAR
 9884 MOUNT ASHLAND SKI RD.
 ASHLAND, OR 97520

PREPARED BY:
 SCOTT FEIN WATER RIGHTS
 SCOTT FEIN, CWRE
 PO BOX 694
 ASHLAND, OR 97520
 541-842-0795
 sfeinsurveyor@gmail.com



PREPARED FOR WATER RIGHTS PURPOSE ONLY.
 NOT FOR PROPERTY BOUNDARY LOCATIONS OR
 DIMENSION

Received
 DEC 18 2024
 OWRD