
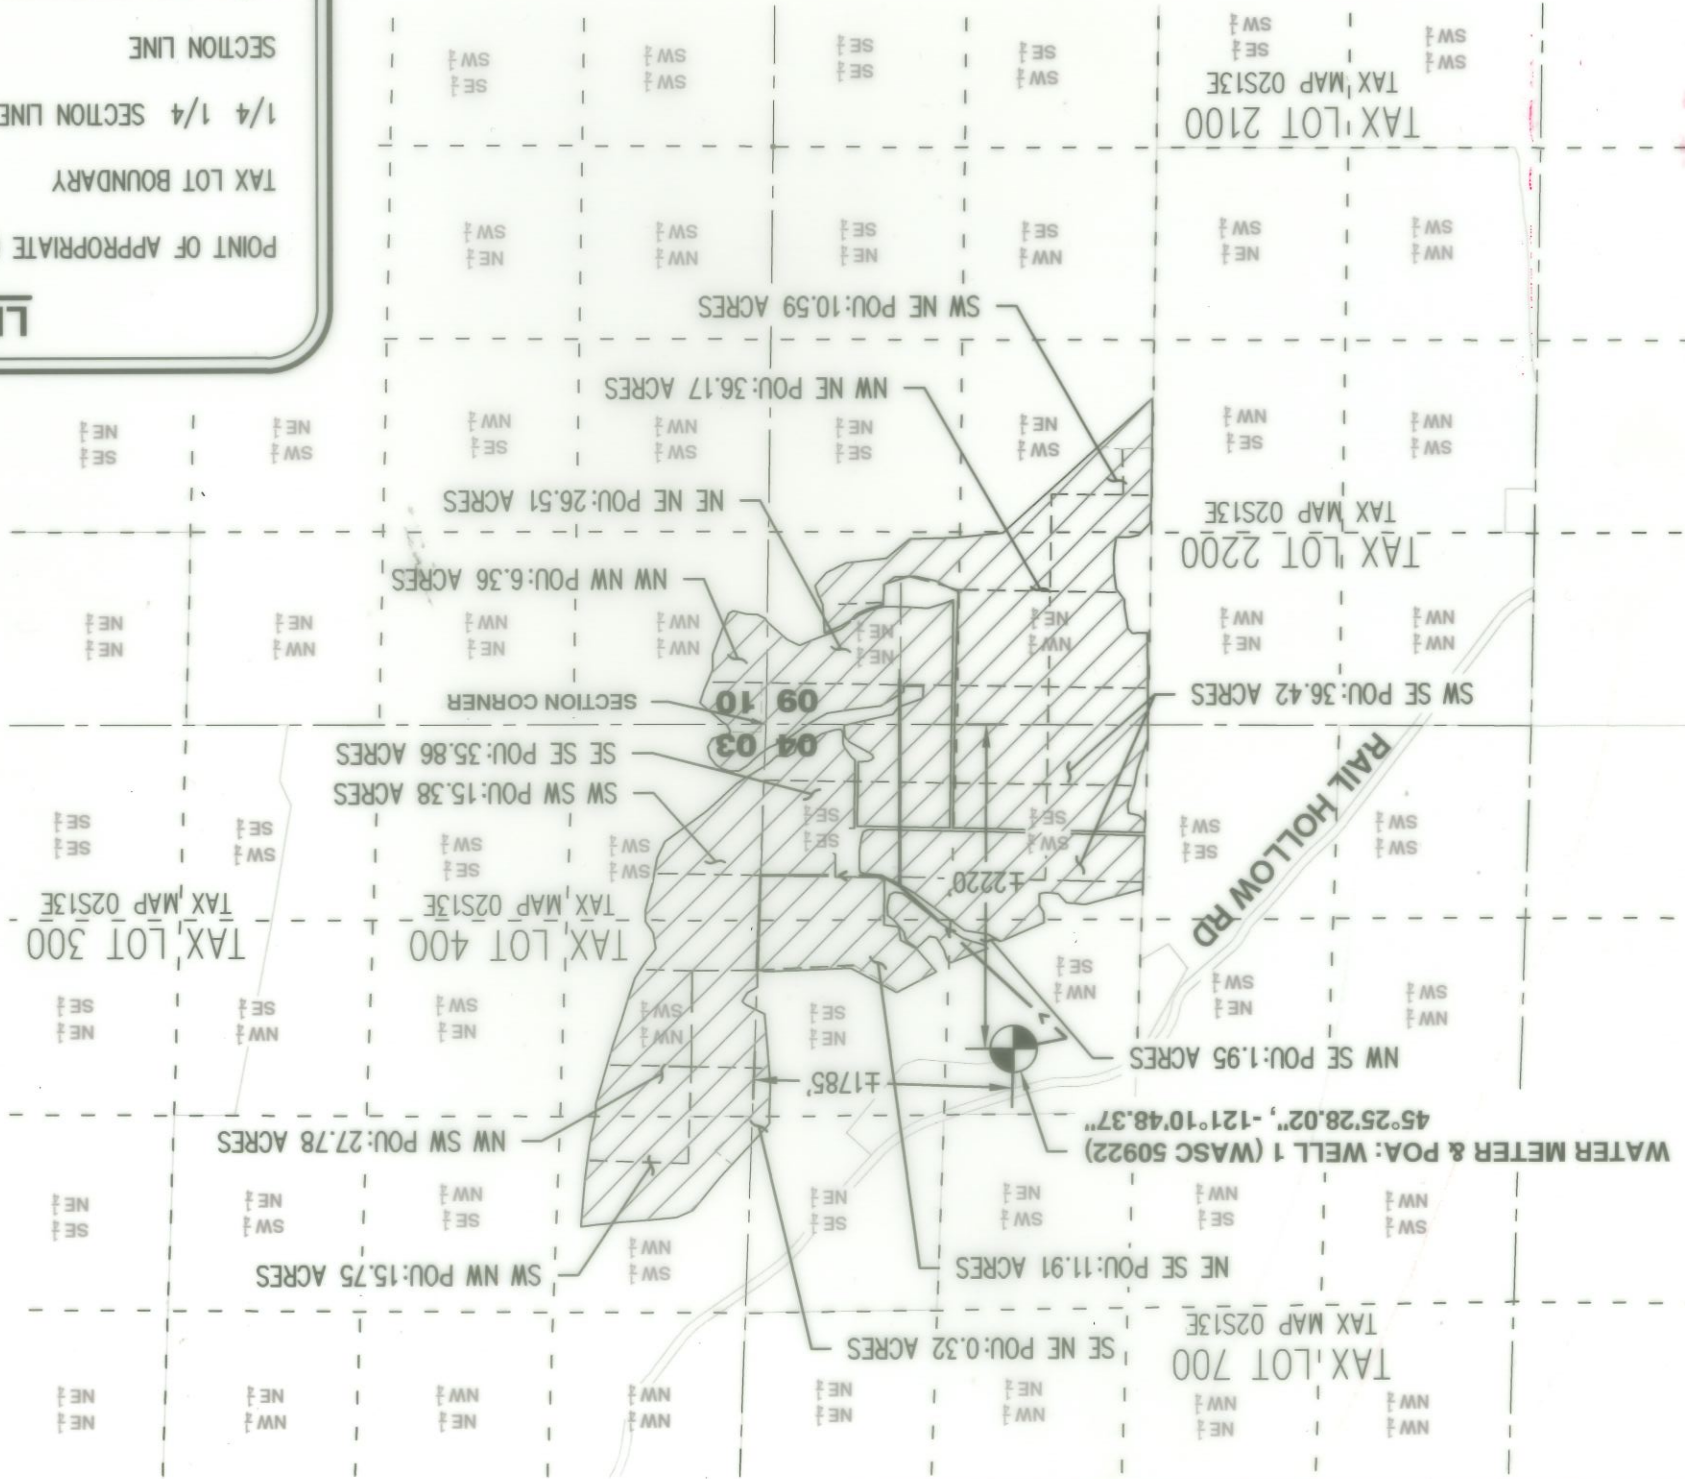


Received
DEC 23 2024
OWRD

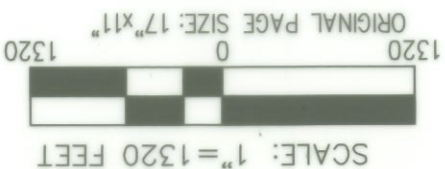

LEGEND

POINT OF APPROPRIATE (POA)

TAX LOT BOUNDARY

1/4 1/4 SECTION LINE

SECTION LINE

10" WATER CONVEYANCE MAINLINE

8" WATER CONVEYANCE LINE

6" WATER CONVEYANCE LINE

4" WATER CONVEYANCE LINE

1.5"-3" WATER CONVEYANCE LINE

PLACE OF USE, IRRIGATION

TOTAL OF 225.0 ACRES

LOCATED IN
SECTIONS 3,4,9,10,
T2S R13E W.M.
WASCO COUNTY, OREGON
CLAIM OF BENEFICIAL USE MAP

TAX LOT 400
TAX MAP 02S13E
APPLICATION G-15299
PERMIT G-15094

CWRE STATEMENT
THIS MAP IS NOT INTENDED TO PROVIDE LEGAL DIMENSIONS OF LOCATIONS OF
PROPERTY OWNERSHIP LINES.

MAP INFORMATION
COORDINATE SYSTEM: STATE PLANE OREGON NORTH ZONE 3601
DATUM: NORTH AMERICAN DATUM OF 1983

DATA SOURCES
TAX LOT AND ROAD: WASCO COUNTY GIS
SECTION LINWORK: WASCO COUNTY GIS

PREPARED FOR
ROBERT LINDELL
82452 RAIL HOLLOW RD
DUFUR, OR 97021



82452 RAIL HOLLOW RD
AKS ENGINEERING & FORESTRY, LLC
12965 SW HERMAN RD, STE 100
TUALATIN, OR 97062
503.563.6151
WWW.AKS-ENG.COM



EXHIBIT
A
DATE: 11/20/2024
DRWN: BGZ
CHKD: SRR
AKS JOB:
11314

COBU MAP # 2132
A-9