

25.0 total acres of irrigation

G-18779


E-RECEIVED
OCT 3, 2019
OWRD



1" = 1320'

Tax Lot:

Township 5 South, Range 5 West, Section 21, Tax Lot 400

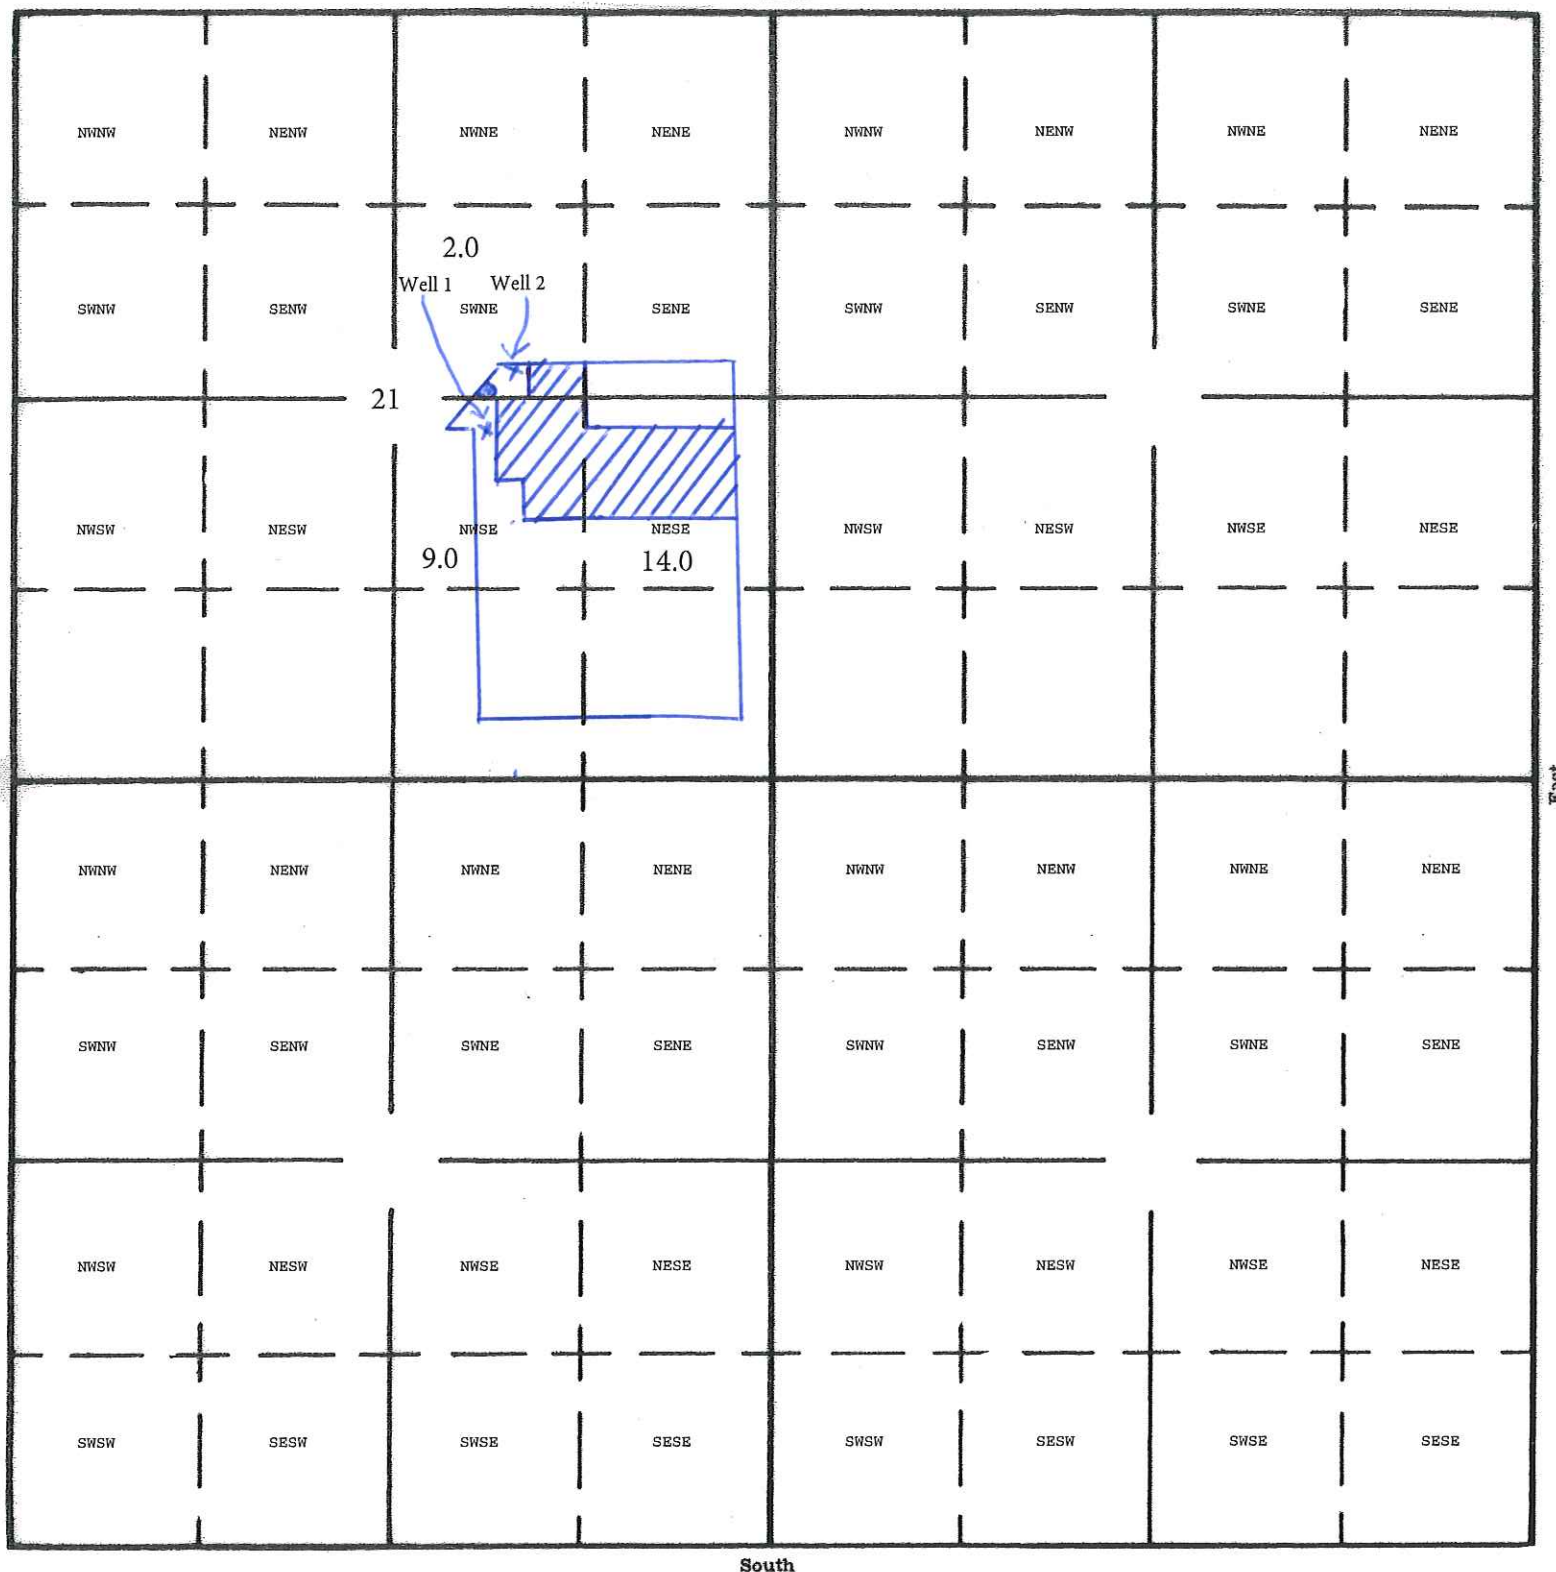

Well 1 YAMH 54039: 2370 North and 1950 West from SE Corner Section 21
Well 2: 2795 North and 1760 West from SE Corner Section 21