


-N-

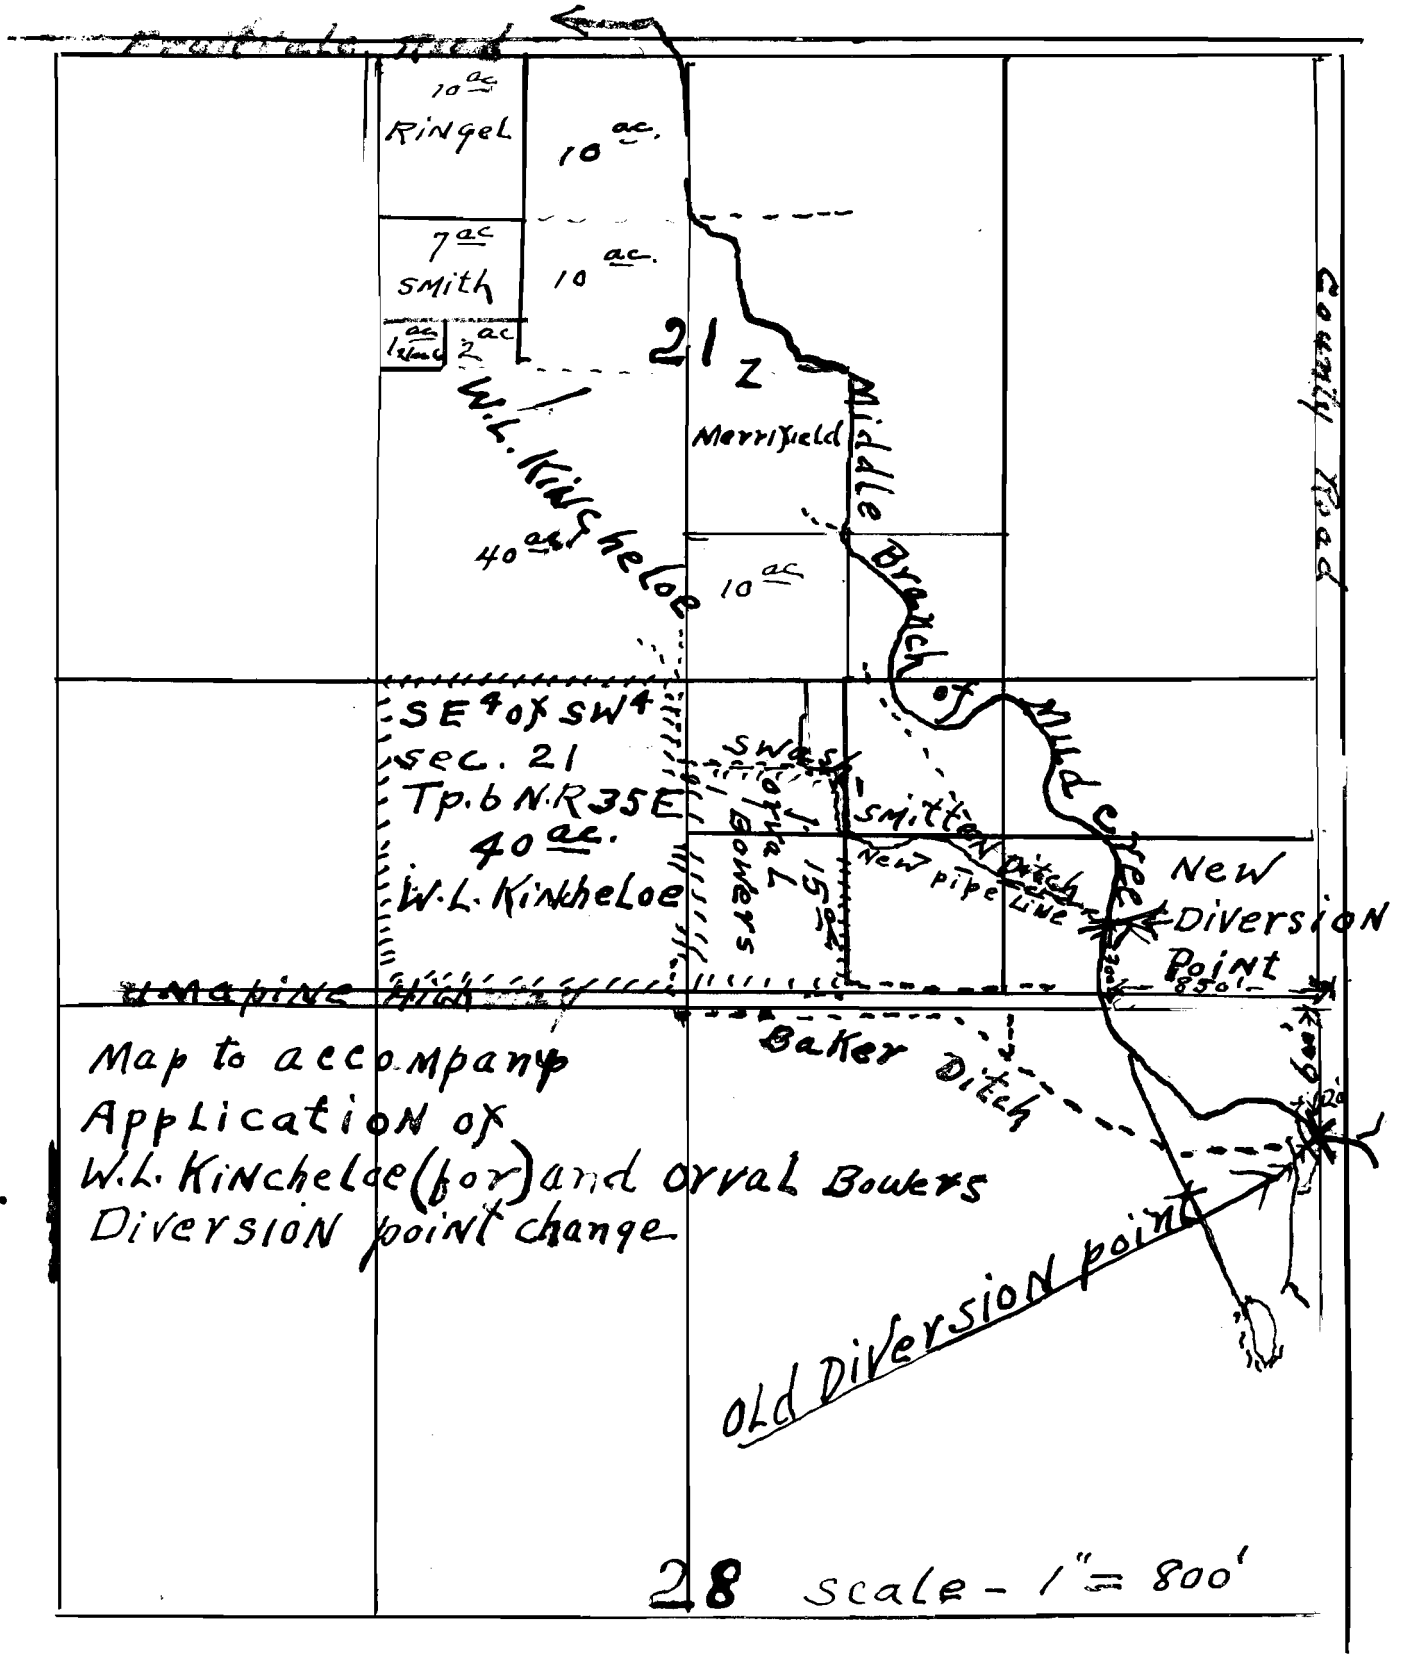

Map to accompany
 Application of
 W.L. Kincheloe (for) and Orval Bowers
 Diversion point change

xor

28 scale - 1" = 800'