



Section 25, T27S, R15E, WM (Lake County)

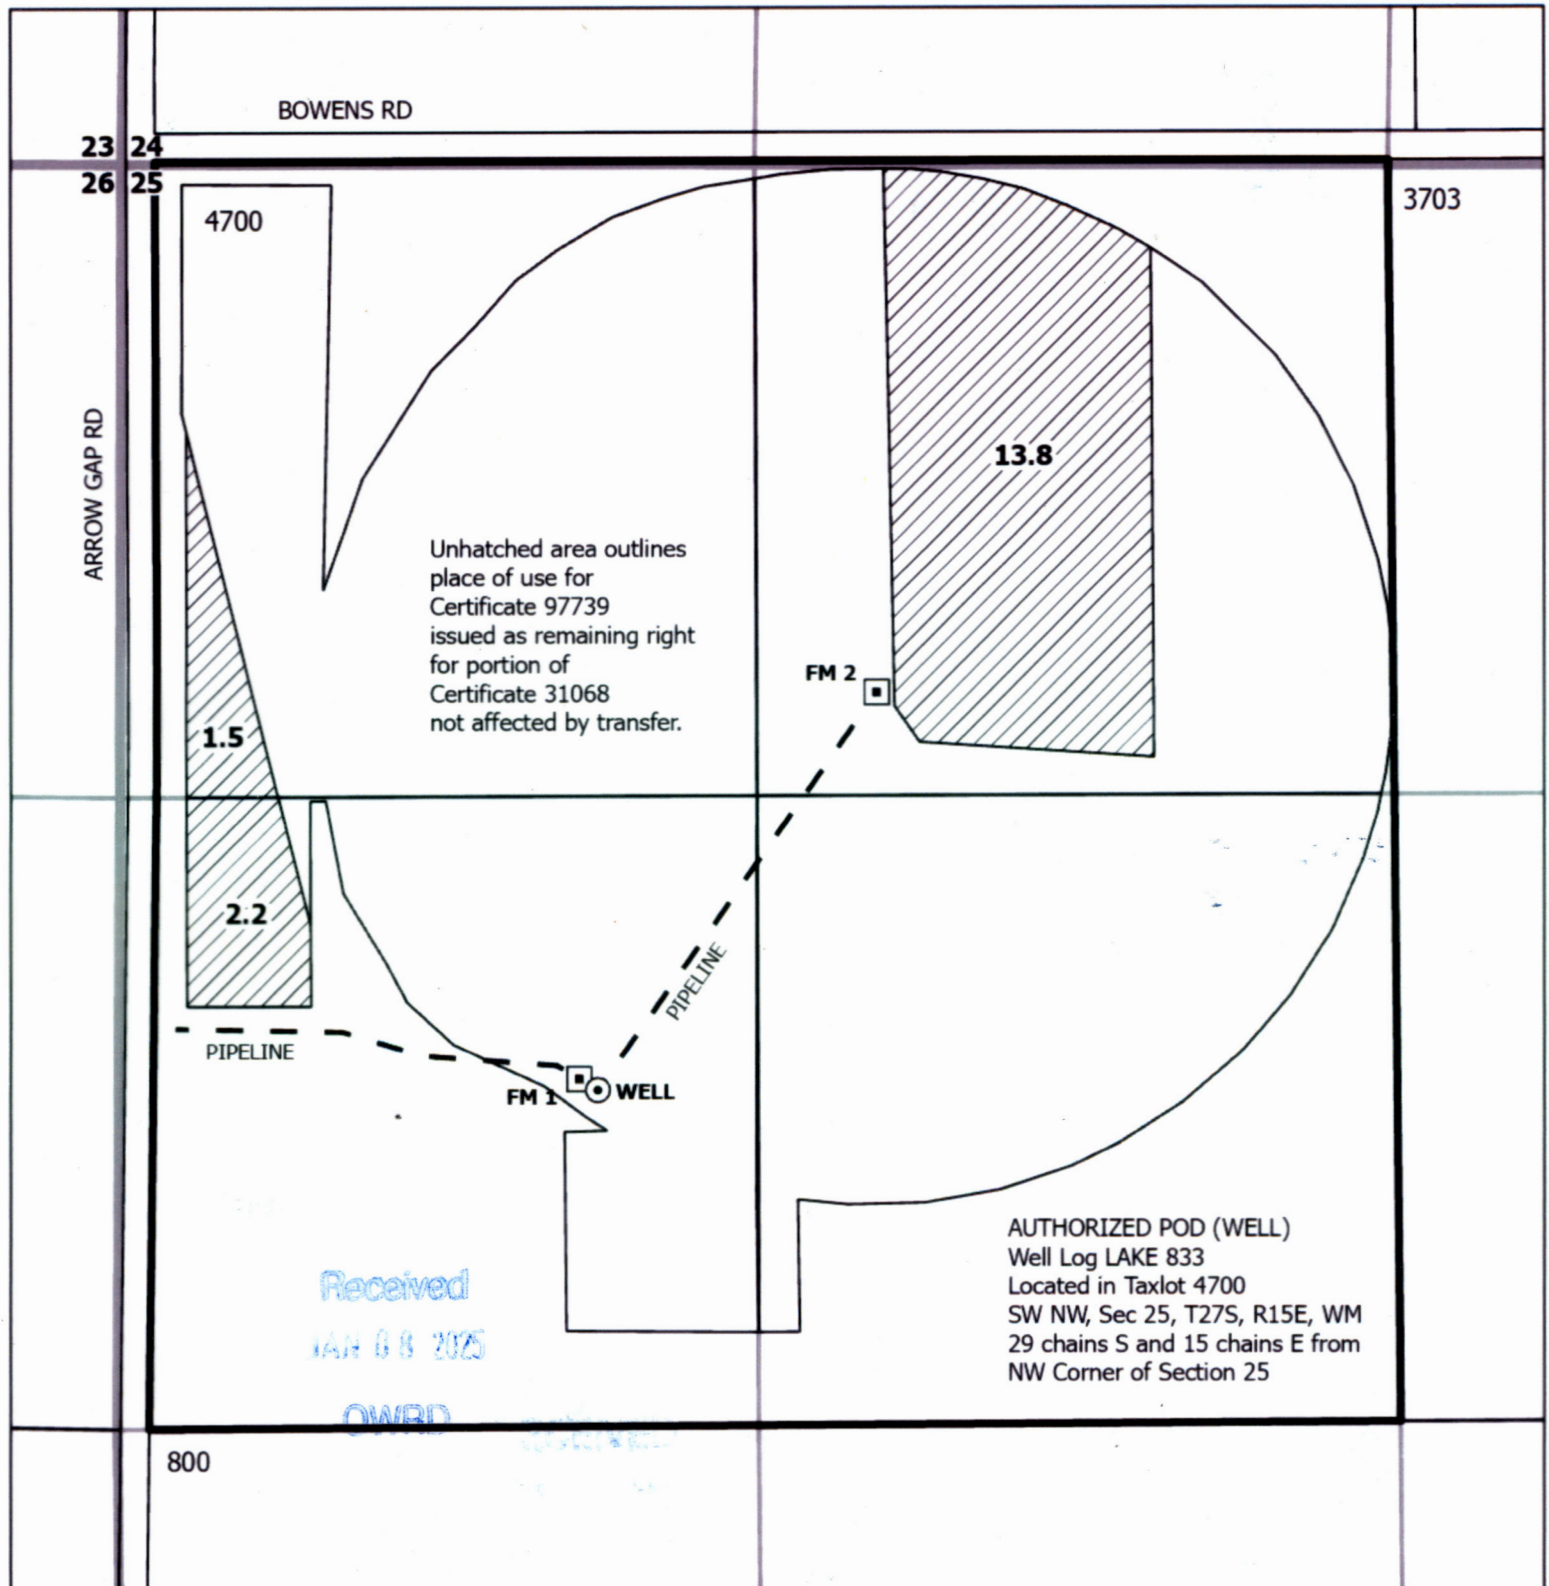

DISCLAIMER
This map is not intended to provide legal dimensions or locations of property ownership lines.



0 100 200 400 US Feet

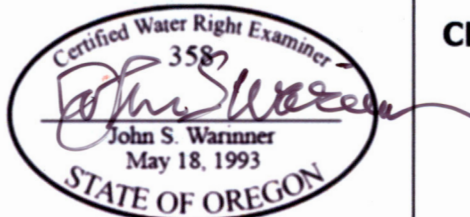

WATERSOLVING LLC
johnw@watersolving.com
(541) 815-4103 mobile

CLAIM OF BENEFICIAL USE MAP

TRANSFER 14025
Certificate 31068
Change Place of Use

CAROL CHUGG
Revised 2024-12-27