


Claim of Beneficial Use Map
Permit S-55135, Application S-88495
A Water Right in the Name of Coquille Indian Tribe
Coos County

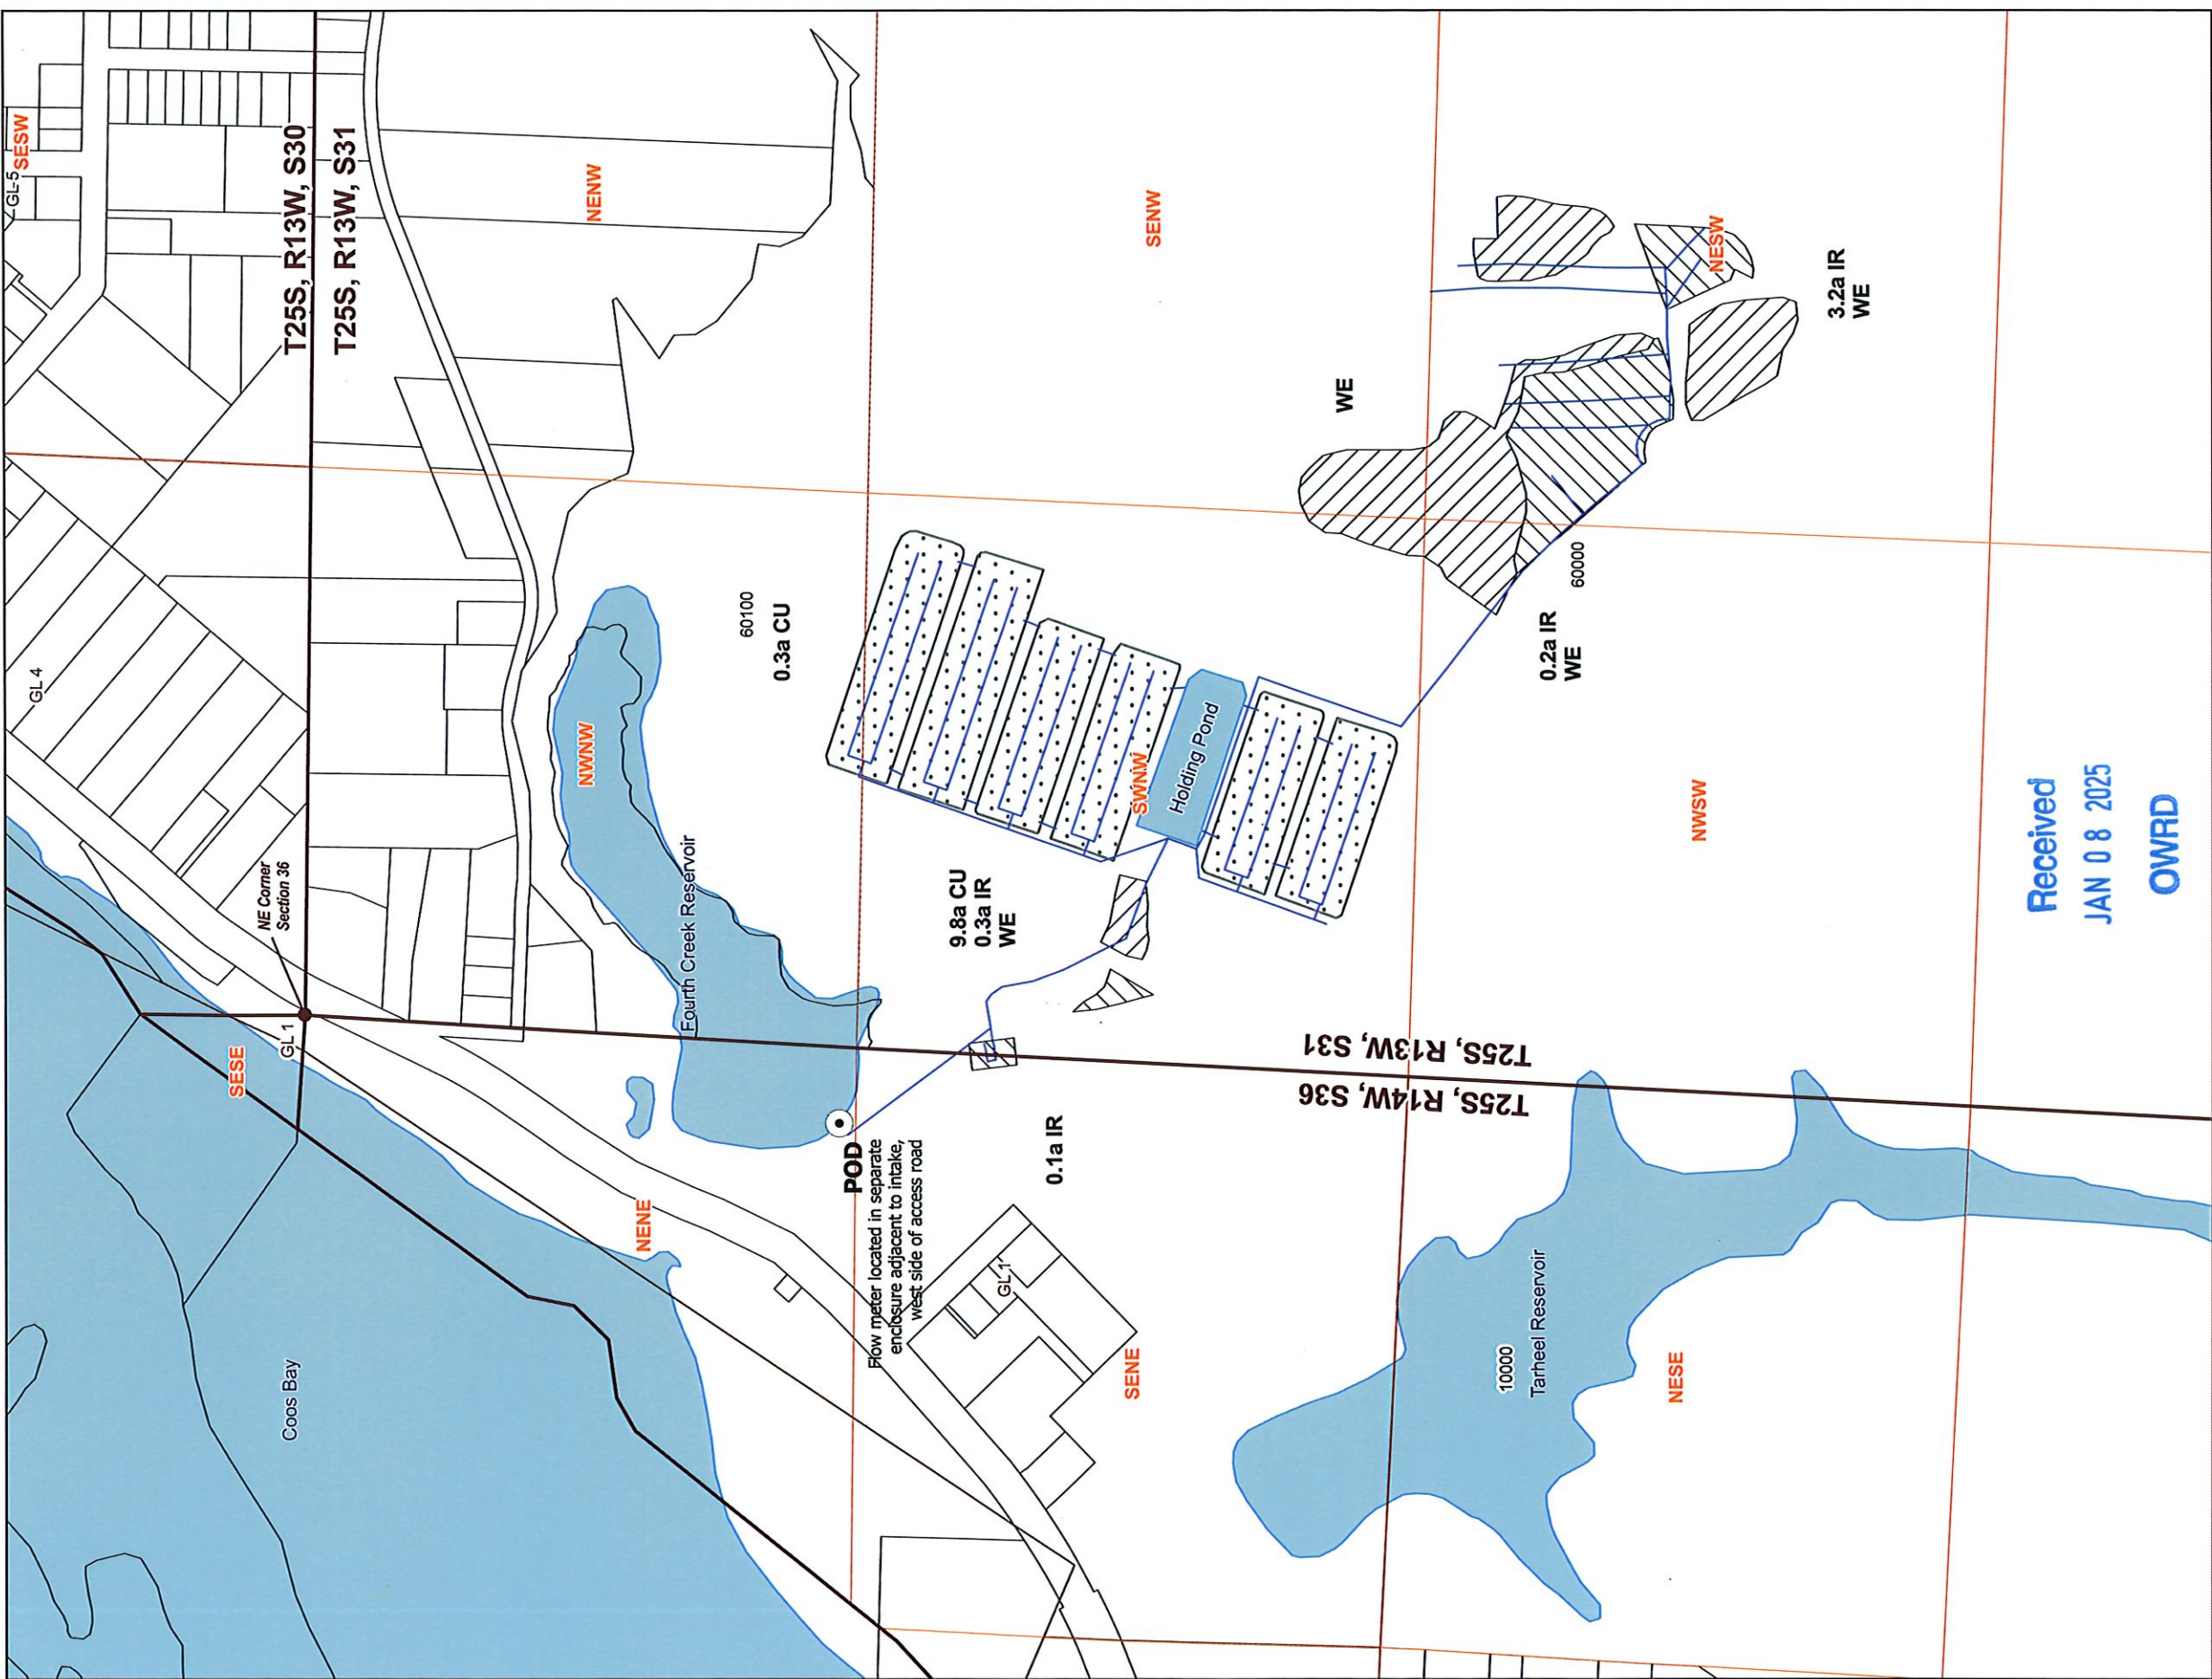

LEGEND

- Point of Diversion (POD)
- Place of Use (POU)
- Cranberry Use (CU)
- Irrigation (IR)
- Wetland Enhancement (WE)
- Holding Pond
- Tax Lots
- Government Lots
- Streams
- Conveyance Mains

POD Location Description

POD Located 1,225 feet South and 177 feet West of the NE corner of Section 36, Township 25 South, Range 14 West (W.M.)

CERTIFIED WATER RIGHT EXAMINER
78185
Theodore R. Ressler
THEODORE R. RESSLER
JUNE 29, 2007
STATE OF OREGON
RENEWS: 12-31-2026

Scale

0 200 400 ft

1-inch = 400 feet

Date: 12/26/2024
Data Sources: BLM, OWRD, USGS, Coos County
Disclaimer: This map is not intended to provide legal dimensions or property ownership lines.

