

VAN LOO COLLECTOR POND

E-RECEIVED
JAN 14, 2025
OWRD



Received by OWRD

APR 09 2024


Salem, OR

THIS APPLICATION MAP
WAS PREPARED FOR THE
PURPOSE OF IDENTIFY THE
LOCATION OF A WATER
RIGHT ONLY & IS NOT
INTENDED TO PROVIDE
LEGAL DIMENSIONS OR
LOCATIONS OF PROPERTY
OWNERSHIP LINES.

Received by OWRD

FEB . 2024

Salem, OR

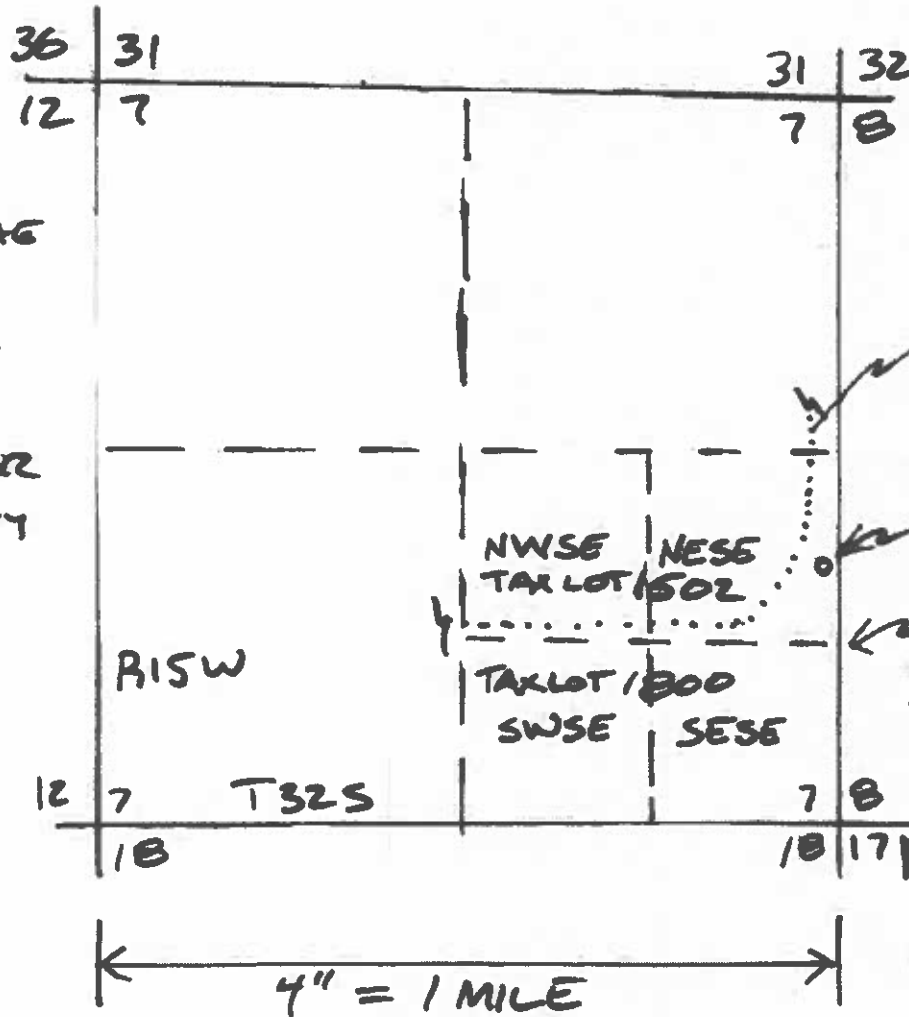

TAX LOT 1502 & 1800
BOUNDARY

COLLECTOR POND

AREA OF USE
SE 1/4 SECTION 7
T32S R15W
(ALL 4 1/4 1/4'S)

SECTION CORNER
REFERENCE:

• COLLECTOR POND/DAM
NORTH 1875'
WEST 200'

• COLLECTOR POND
SEEPAGE/SPRING
NORTH 1875' & WEST 50'

TOM GRUSZCZENSKI 12/04/2023