

THIS MAP WAS PREPARED FOR
ASSESSMENT PURPOSE ONLY

SECTION 15 T3S R2W W.M.
YAMHILL COUNTY

3 2 15
& INDEX

CANCELLED
101
503
1001
1002
1005
1601
1603
1605
1903
2500


~~Dam~~
Reservoir is southeast
quarter of the northeast
quarter and approx. 250
feet west and 1750 feet
south from the northeast
corner of section 15

GPS 45.312 314N-122909743

E-RECEIVED

Jan 13th 2025

OWRD

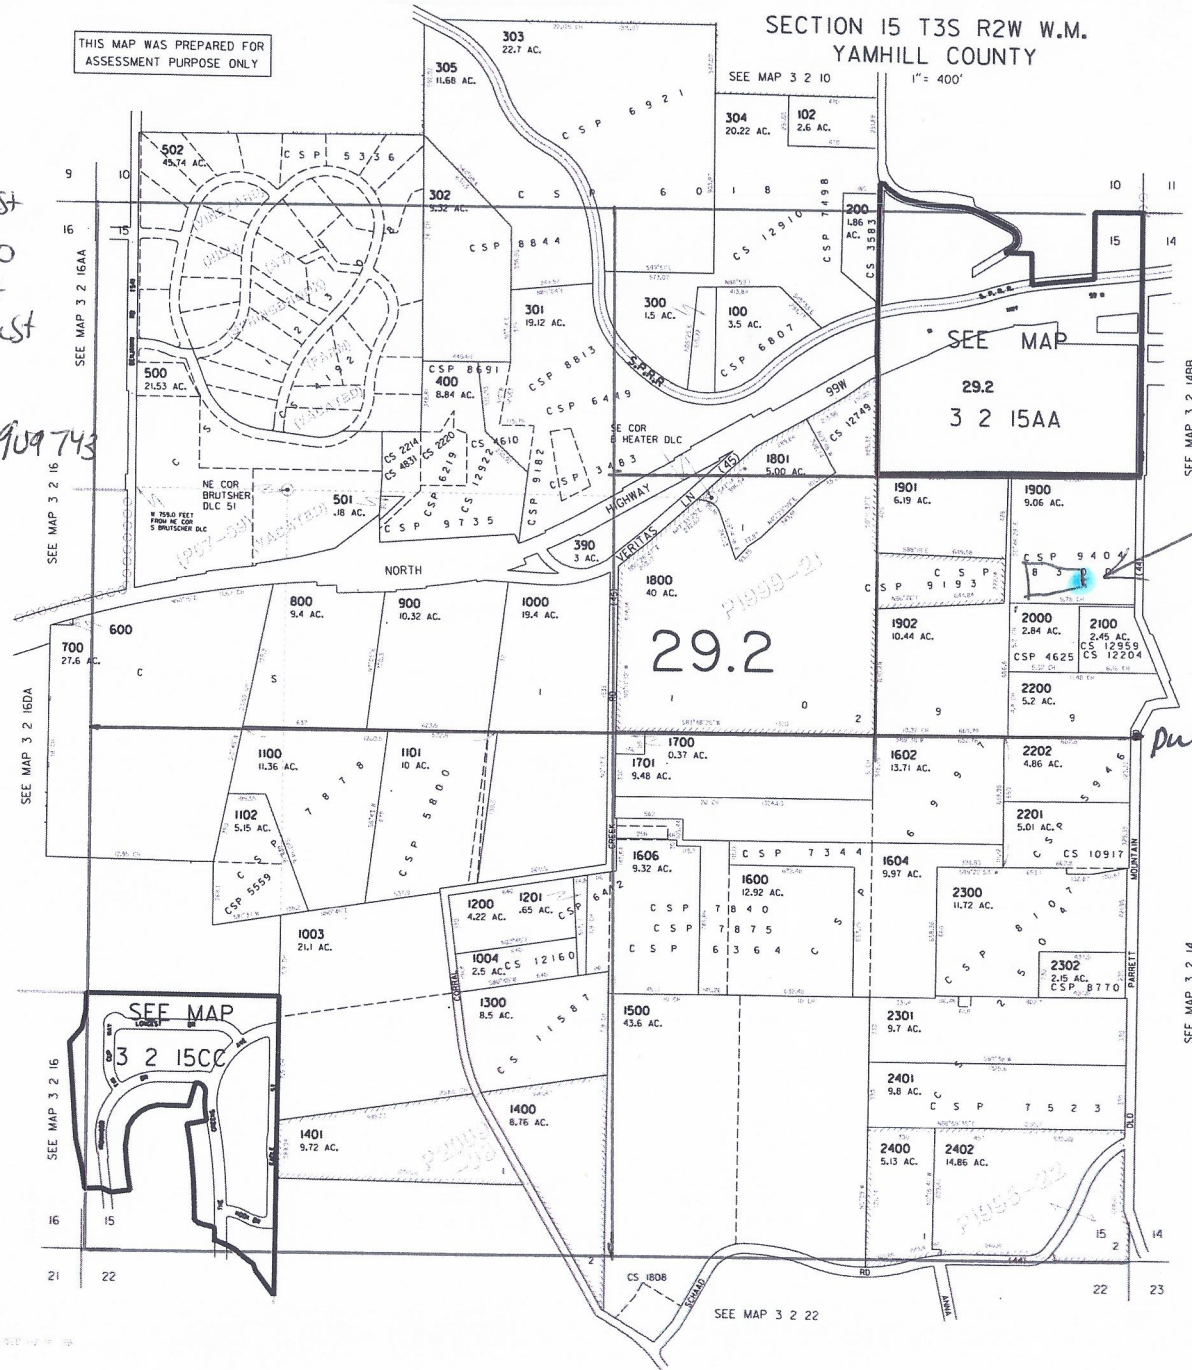

proposed
~~reservoir~~
dam

Pub. land survey corner



Scale: 1" = 1000 ft.

3 2 15