


Claim of Beneficial Use - NW Urban Holdings, LLC

Application S-88750, Permit S-55265

Township 6S, Range 4W, W.M.

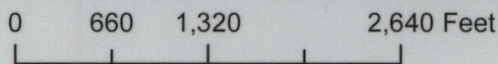

This map is not intended to provide legal dimensions or locations of property ownership lines.

Legend

- IR POU
- Mark Olson Reservoir (Cert. 83073)
- Diversion Pipe
- Mainline
- Taxlots
- DLC



Received by OWRD EXPIRES: 12-31-2026

JAN 17 2025

Salem, OR