

**CLAIM OF
BENEFICIAL USE**
**for Reservoirs storing less than
9.2 acre-feet permitted under
ORS 537.409**



Oregon Water Resources Department
725 Summer Street NE, Suite A
Salem, Oregon 97301-1266
(503) 986-0900
www.oregon.gov/OWRD

A fee of \$230 must accompany this form.
The Claim will be returned if the fee is not included.

This form may be completed by the permit holder of record if:

- 1) The permit was issued under the authority of ORS 537.409; and
- 2) No secondary permit exists for the use of water stored in the reservoir; and
- 3) The developed capacity of the reservoir is less than 9.2 acre-feet; and
- 4) The water was stored by the date required in the permit; and

A separate form shall be completed for each permit.

This form must be submitted to the Water Resources Department within one year of storage of water in the reservoir.

Please type or print in dark ink. If the data provided is found to contain errors or omissions, it may be returned. The Department may require the submittal of additional information.

If you have questions regarding the completion of this form, please call 503-979-9103.

**SECTION 1
GENERAL INFORMATION**

File Information:

APPLICATION # R- 88 736	PERMIT # R- 154 26
-----------------------------------	------------------------------

Received
JAN 21 2025
OWRD

Applicant Information:

APPLICANT NAME Jerry NANCE		PHONE NO. 541 517 5073	ADDITIONAL CONTACT NO. 541 567 1948	
ADDRESS 55916				
CITY Heppner	STATE Oregon	ZIP 97886	E-MAIL The LAZY I @bnael.com	

SECTION 2
RESERVOIR INFORMATION

Reservoir Dimensions and Capacity:

AVERAGE LENGTH	AVERAGE WIDTH	AVERAGE DEPTH	MAXIMUM CAPACITY IN ACRE-FEET
150'	150'	6'	3.099

To determine capacity in acre-feet use for the above table, use the following calculation:

$$\text{Acre-feet} = \frac{(\text{Average Length})(\text{Average Width})(\text{Average Depth})}{43,560}$$

SECTION 3
MAP

Attach a map identifying the reservoir location. If the water right application map accurately reflects the location of the reservoir, you may attach a copy of it. Otherwise, you must submit a map meeting the standards of OAR 690-310-0050, which are attached.

Preparation of the map by a Certified Water Rights Examiner is **not** required for this type of permit, but may be submitted.

SECTION 4
SIGNATURE

This Claim of Beneficial Use must be signed by each permit holder of record.


By my signature, I certify that the information contained herein is true and correct to the best of my knowledge.

SIGNATURE	PRINT OR TYPE NAME	TITLE	DATE
Jerry Nance	Jerry Nance	owner	1-13-2025

Received

JAN 06 2025

OWRD

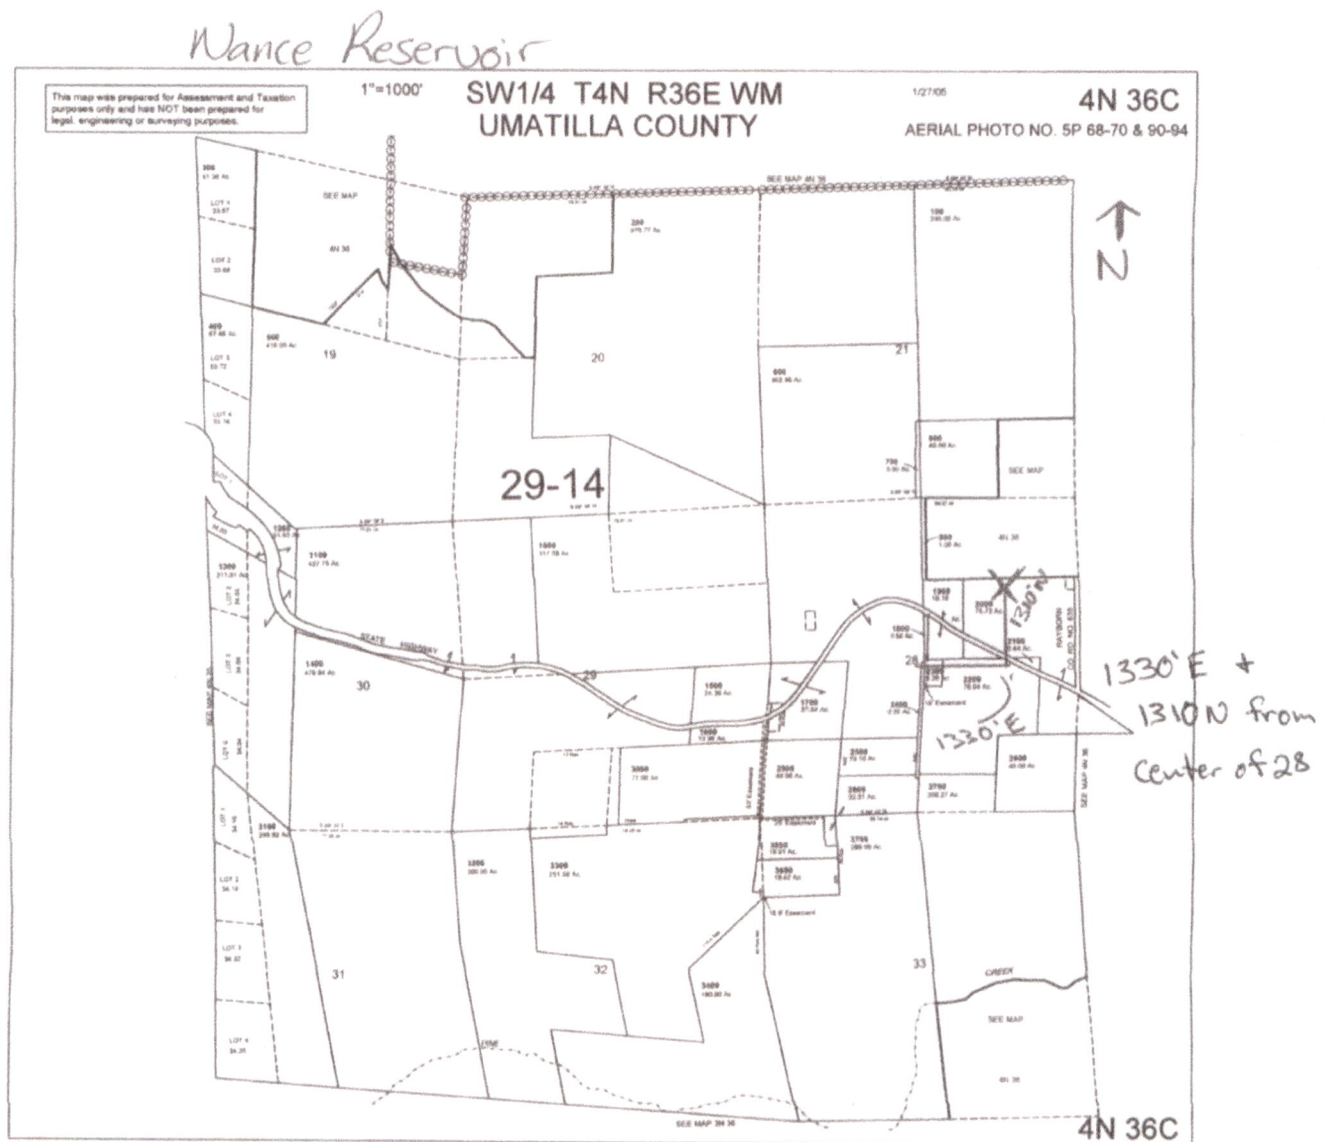

Nance Reservoir

4N 36E Section 28 SENE

1330' E + 1310' N from Center of Section 28

Tax Lot 2000

RECEIVED

AUG 28 2019

OWRD

RECEIVED

AUG 19 2019

OWRD


Received

JAN 21 2025

OWRD

R-88736

If the diversion involves a dam, use this space for sketches of the diversion (e.g. cross-section of the dam with its dimensions, dimension and placement of outlet pipe, means of passing live flow outside of the authorized storage season, and means for providing fish passage).

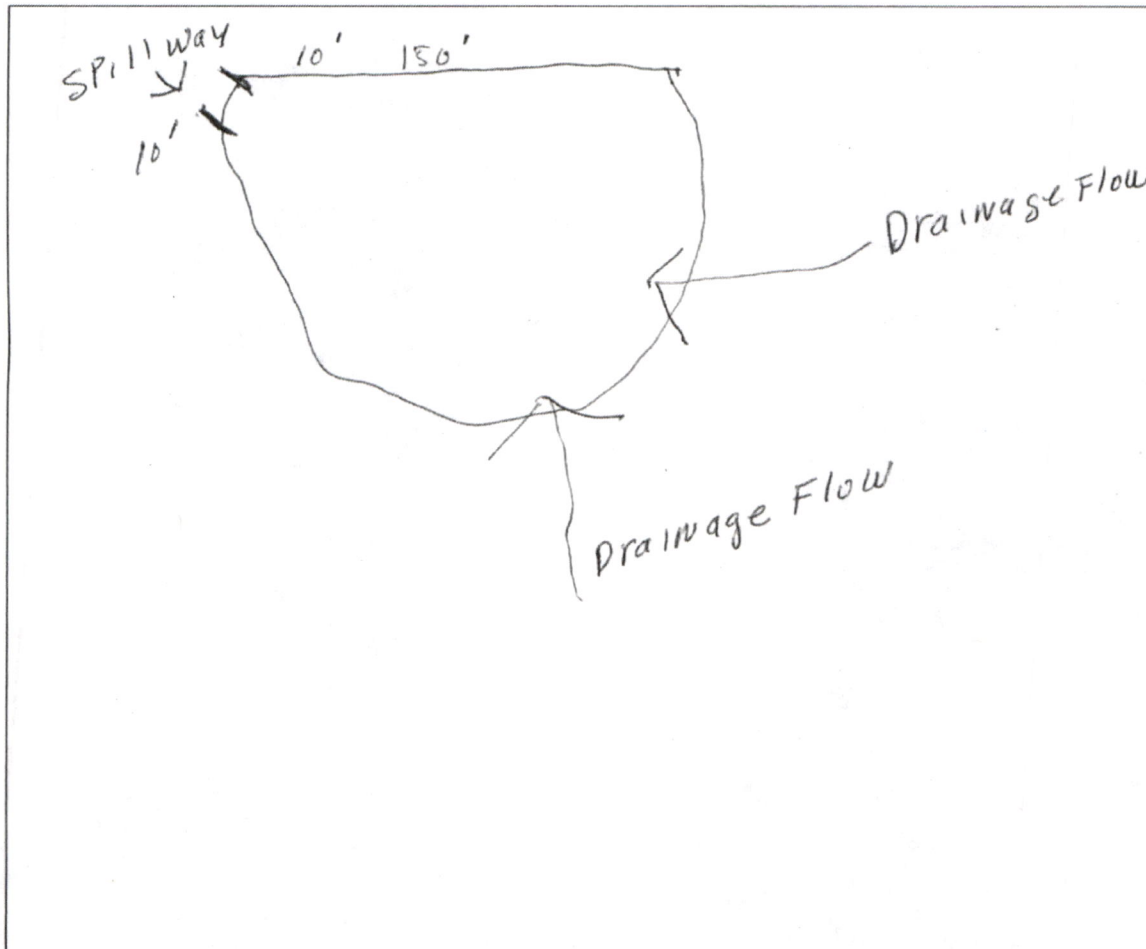

9. SIGNATURE

I swear that all statements made and information provided in this application are true and correct to the best of my knowledge.

Jerry Wince
Applicant Signature

Aug 13 - 2019 RECEIVED
Date

AUG 28 2019

OWRD
RECEIVED

AUG 19 2019

OWRD

Before you submit your application be sure you have:

- Answered each question completely.
- Included a legible map that includes Township, Range, Section, quarter-quarter and tax lot number.
- The map must meet map requirements to be accepted.
- Included a land use form or receipt stub signed by a local planning official.
- Included a check payable to Oregon Water Resources Department for the appropriate amount.

Received
JAN 21 2025
OWRD