


T.5S. R.1W. Sec. 1 & 2, W.M.

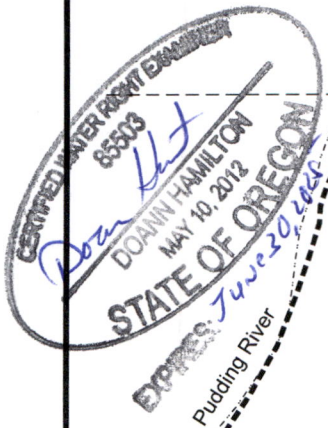


Well 1 (CLAC 2012) is located 1,120 feet north and 585 feet east from the SW corner, Section 1.




Well 3 (CLAC 60252) is located 835 feet north and 895 feet east from the SW corner, Section 1.


Well 4 (CLAC 2008) is located 190 feet north and 700 feet west from the SE corner, Section 2.

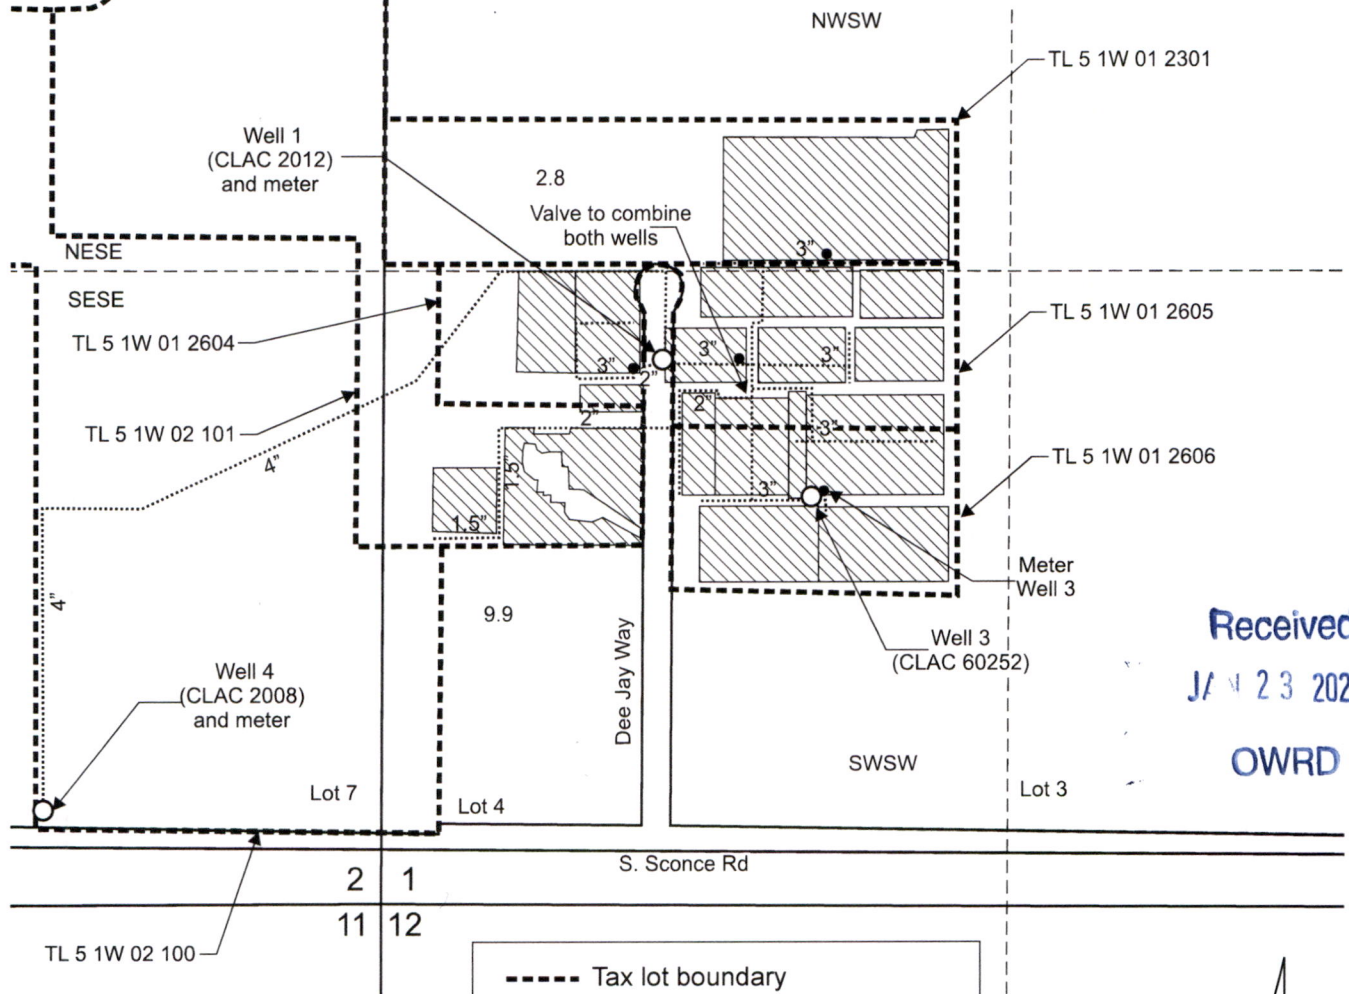 Area (12.7 Acres) of agricultural use (nursery use) and irrigation under T-14163, formerly Certificate 96771.



Received
JAN 23 2025
OWRD

-  Tax lot boundary
-  Irrigation mainlines
-  Injection locations

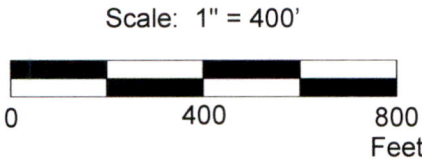

This map was prepared for the purpose of identifying the location of a water right only and is not intended to provide legal dimensions or location of property ownership lines.

Claim of Beneficial Use Map
T-14163, formerly Certificate 96771

Jack Bigej
T.5S. R.1W. Sec. 1 & 2, W.M.

01/2025

AIGardenT-14163COBUMap.cdr

Pacific Hydro-Geology Inc.