T.4S. R.2W. Section 30, and T.4S. R.3W. Section 25, W.M.

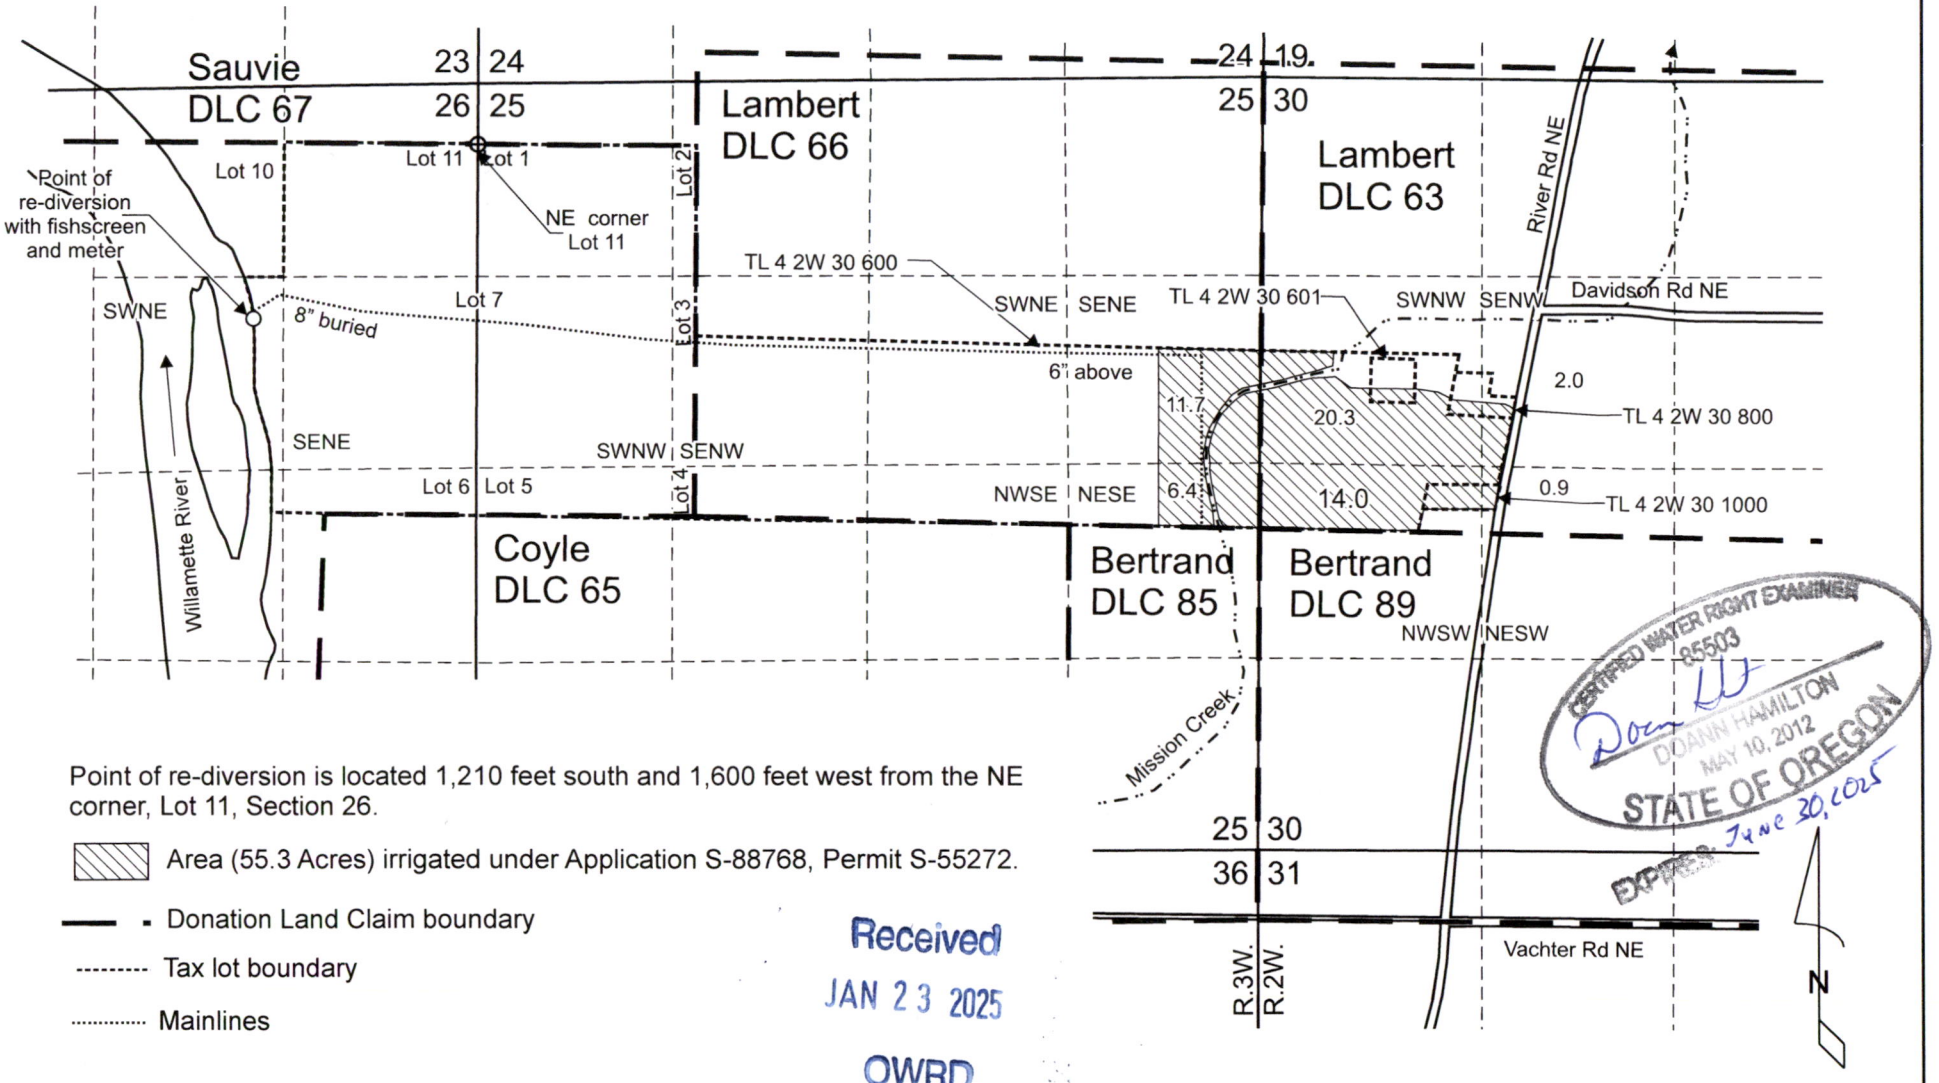

Point of re-diversion is located 1,210 feet south and 1,600 feet west from the NE corner, Lot 11, Section 26.

Area (55.3 Acres) irrigated under Application S-88768, Permit S-55272.

Donation Land Claim boundary

Tax lot boundary

Mainlines

Received
JAN 23 2025
OWRD

CERTIFIED WATER RIGHT EXAMINER
85503
DOANN HAMILTON
MAY 10, 2012
STATE OF OREGON
EXPIRES: June 30, 2025

Scale: 1" = 1,320'

0 1,320 Feet

This map was prepared for the purpose of identifying the location of a water right only and is not intended to provide legal dimensions or location of property ownership lines.

Pacific Hydro-Geology Inc.

Claim of Beneficial Use Map
Application S-88768, Permit S-55272

Old Hill LLC, c/o Tony Smith
T.4S. R.2W. Section 30 and
T.4.S R.3W. Section 25, W.M.

01/2025

SmithS-88768COBUMap.cdr