


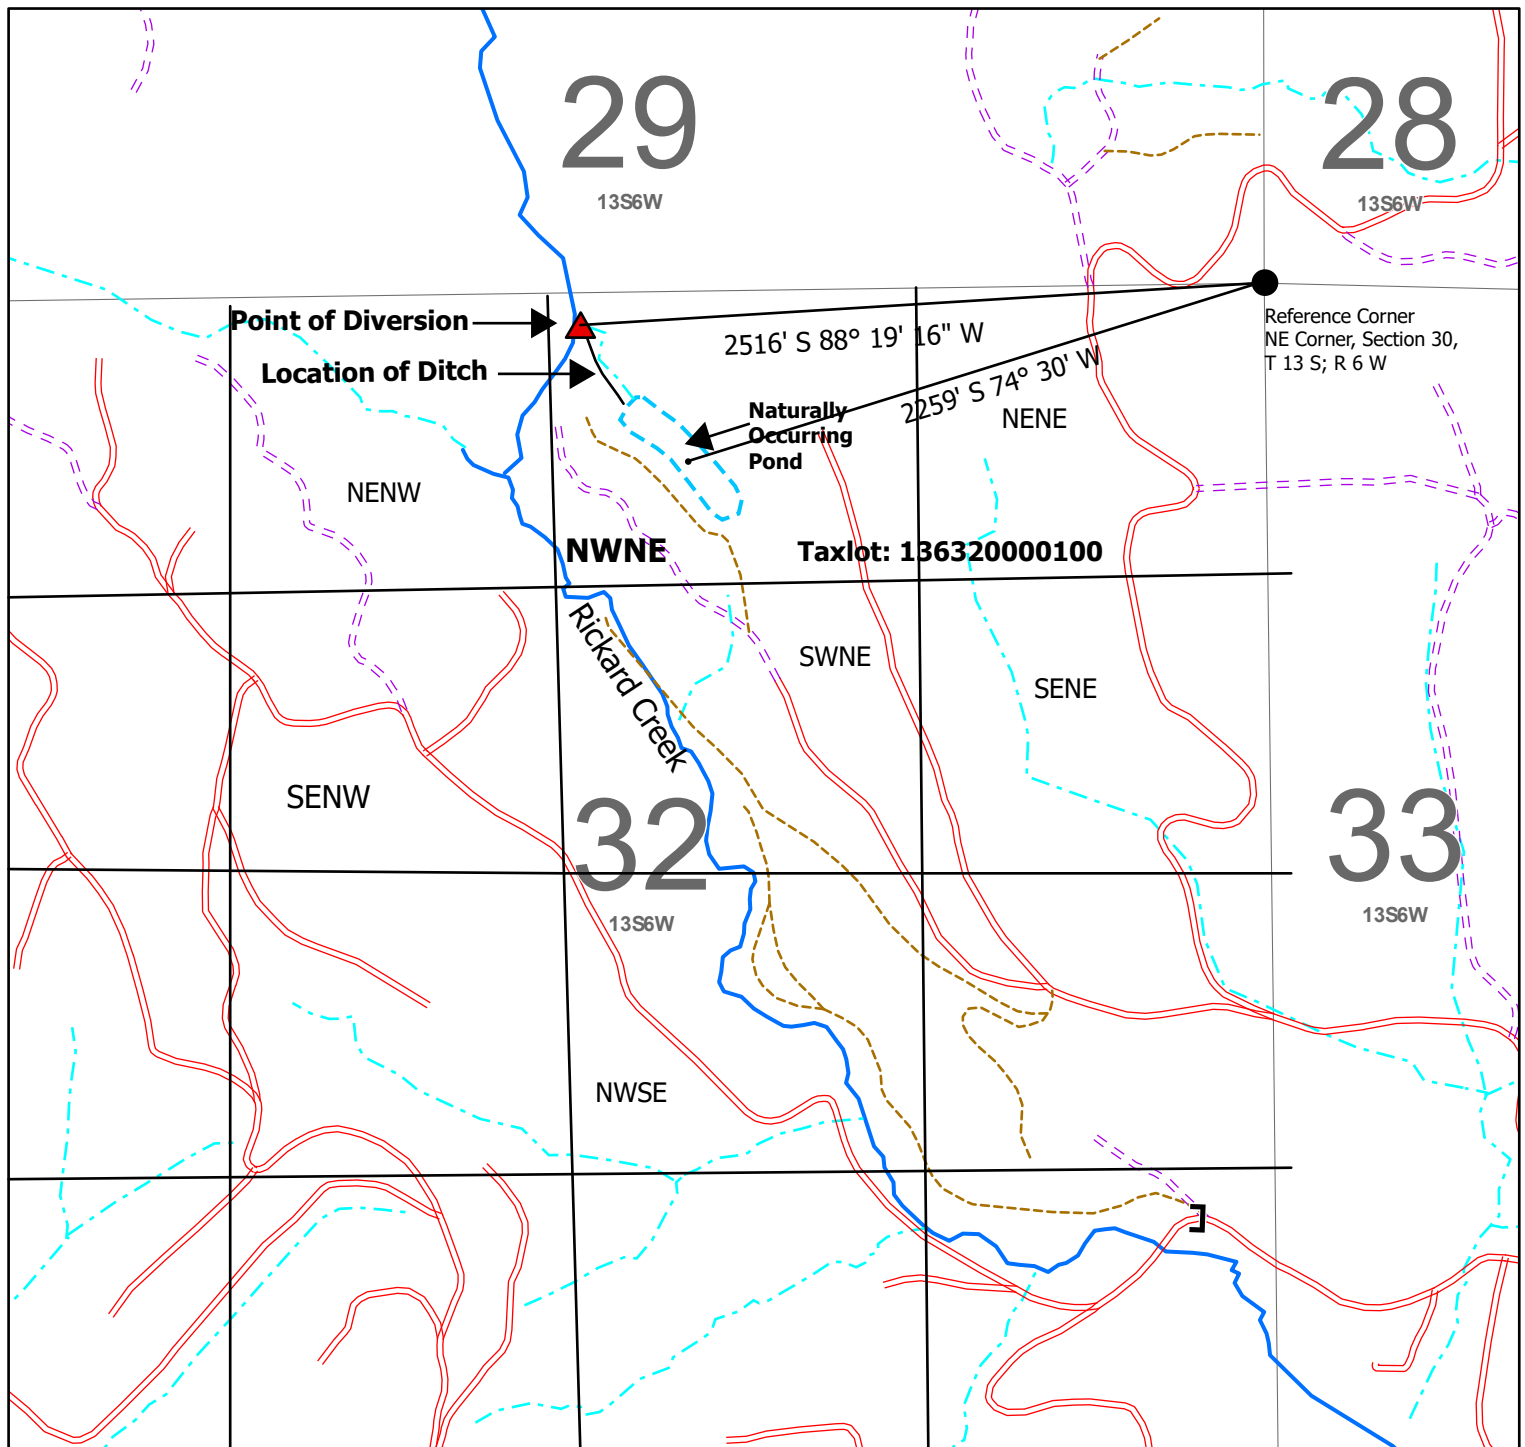

**Rickard Pond Duck Habitat Project
Starker Forests - in Partnership with
Ducks Unlimited**

August 16, 2024

NWNE Section 32, T 13 S; R 6 W

Taxlot: 136320000100

Reference Corner:

NE corner, Section 32, T 13 S; R 6 W

**Distance/Bearing to location of diversion:
2516', S 88° 19' 16" W**

**Distance/Bearing to location of center of
pond:
2259', S 74° 30' W**

1 in = 1,000 feet

Legend	
Gates	Streams SFI
Roads SFI	Stream Class
Road Surface	Lake
Highway	Pond
Paved	River
Rock	Perennial
Dirt	Seasonal
Trail	Draw
Tiger Labels	Sections
Railroads	



**STARKER
FORESTS, INC.**

7240 SW Philomath Blvd.
PO Box 809
Corvallis, OR 97339
541-929-2477 (Office)
541-929-2178 (Fax)
www.starkerforests.com