

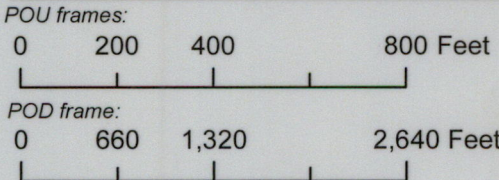
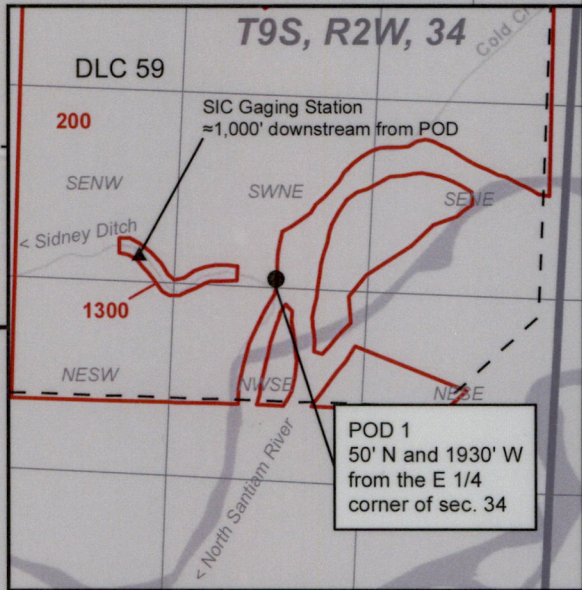


Sidney Irrigation Cooperative - Claim of Beneficial Use Transfer T-13050

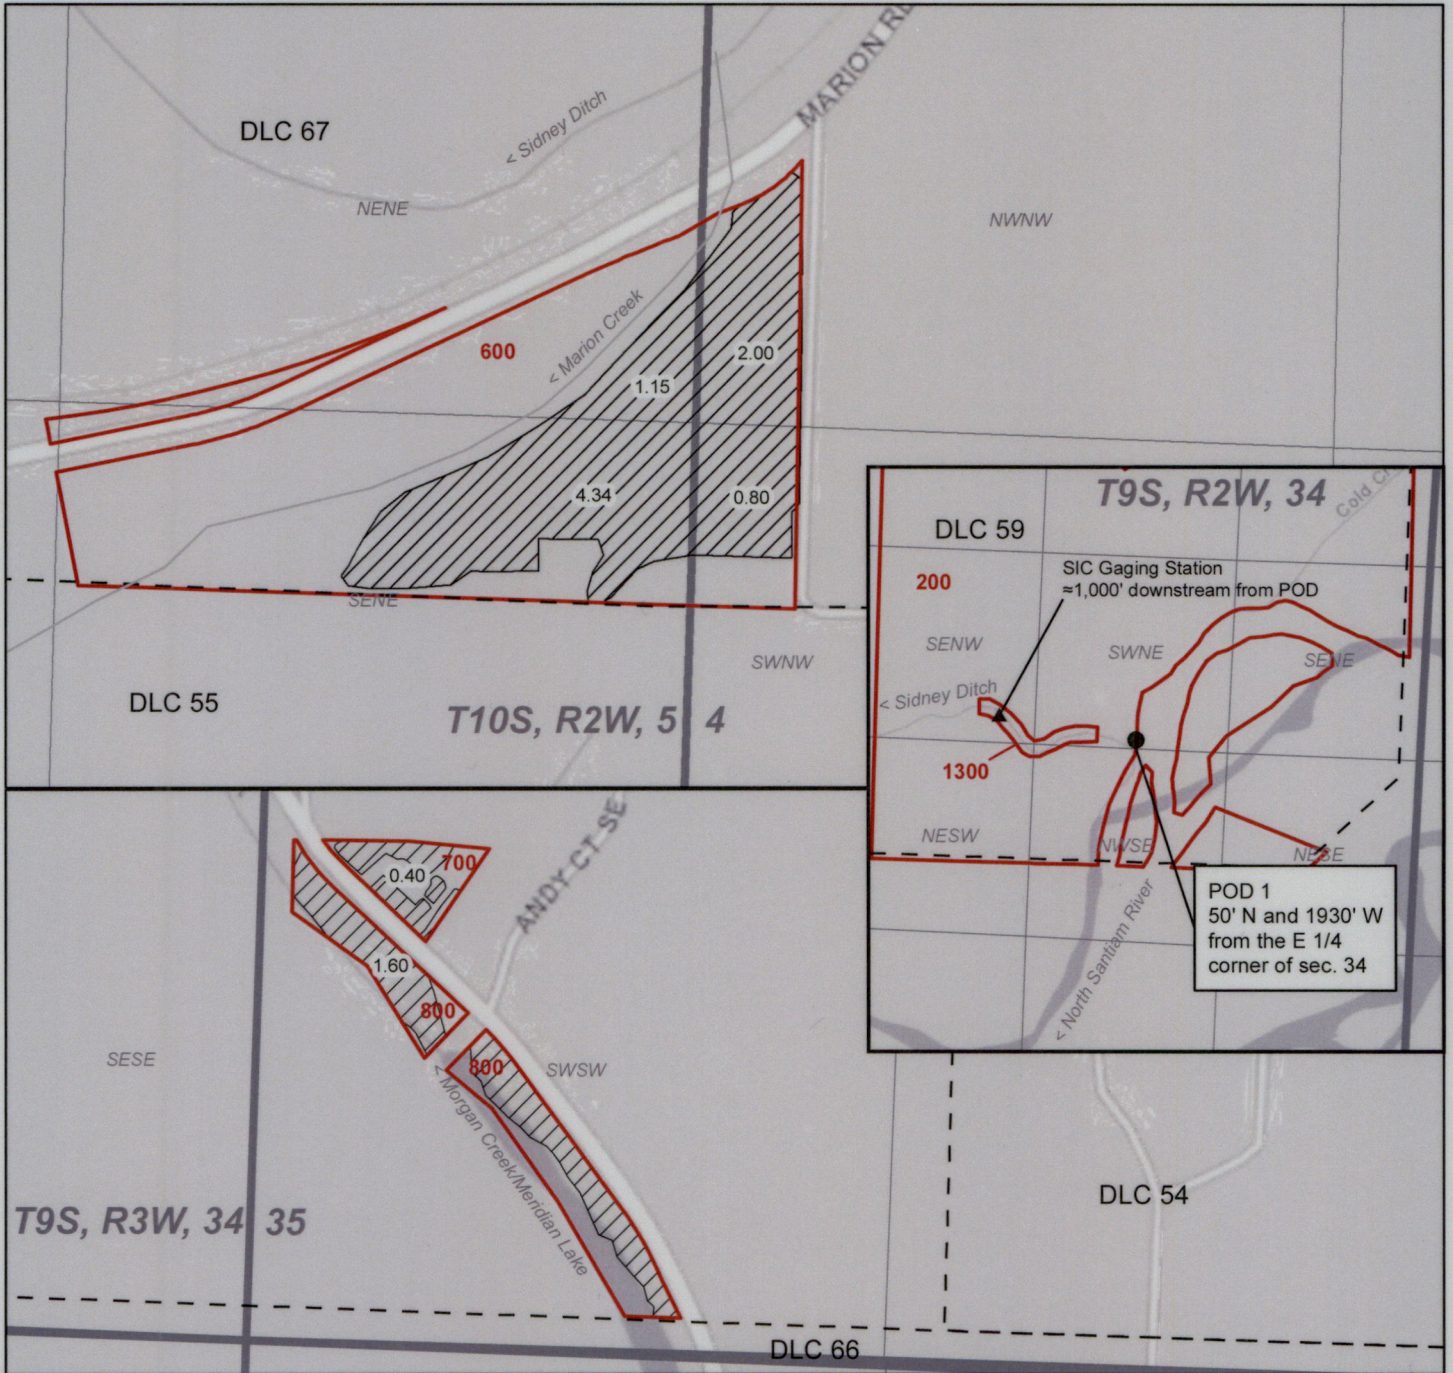

This map is not intended to provide legal dimensions or locations of property ownership lines.

- Legend**
- IR POU
 - Taxlot
 - DLC

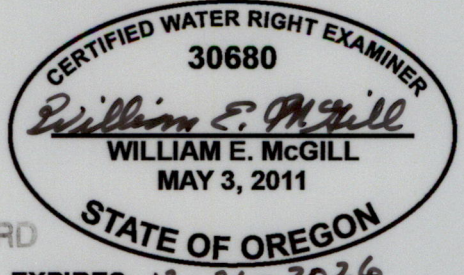

Received by OWRD
JAN 31 2025

EXPIRES: 12-31-2026