

LEGEND

- ⊙ Point of Appropriation (POA)
- M Meter
- ▨ Place of Use (POU)
- Major Road
- ~ Watercourse
- Waterbody

All Other Features

- Tax Lot

**Claim of Beneficial Use Map
Blue River Water District
T-9338**


Lane County
Township 16 South, Range 4 East (W.M.)

Received by OWRD

JAN 21 2025

Salem, OR

CERTIFIED WATER RIGHTS EXAMINER STAMP

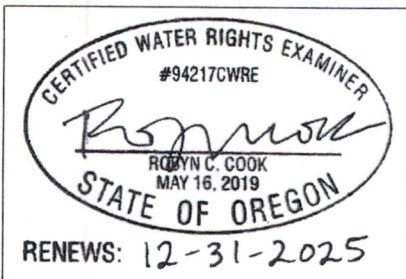

LOCATION DESCRIPTION

Well 1, LANE 9594
Located 757 feet South and 38 feet West from the SW corner of NENW, of Section 29, Township 16 South, Range 4 East (W.M.)
Well 2, LANE 62604
Located 752 feet South and 30 feet West from the SW corner of NENW, of Section 29, Township 16 South, Range 4 East (W.M.)

DISCLAIMER
This map was prepared for the purpose of identifying the location of a water right only and it is not intended to provide legal dimensions or location of property ownership lines.

Date: December 10, 2024
Data Sources: BLM, ESRI, OWRD, USGS

