
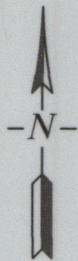


CLAIM OF BENEFICIAL USE MAP

TRANSFER APPLICATION: T-14167
IRRIGATION


FOR
PETER SAGE AND DEBRA FEE JING LEE
305 HARVARD PLACE
MEDFORD, OR 97504

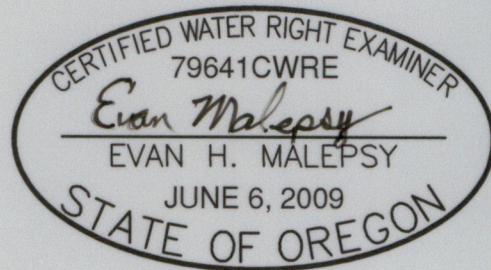

0 200 400
SCALE: 1"=400'

SITUATED IN
SECTION 10, TOWNSHIP 36 SOUTH, RANGE 2 WEST, W.M.
JACKSON COUNTY, OREGON

RENEWES: 12/31/2026

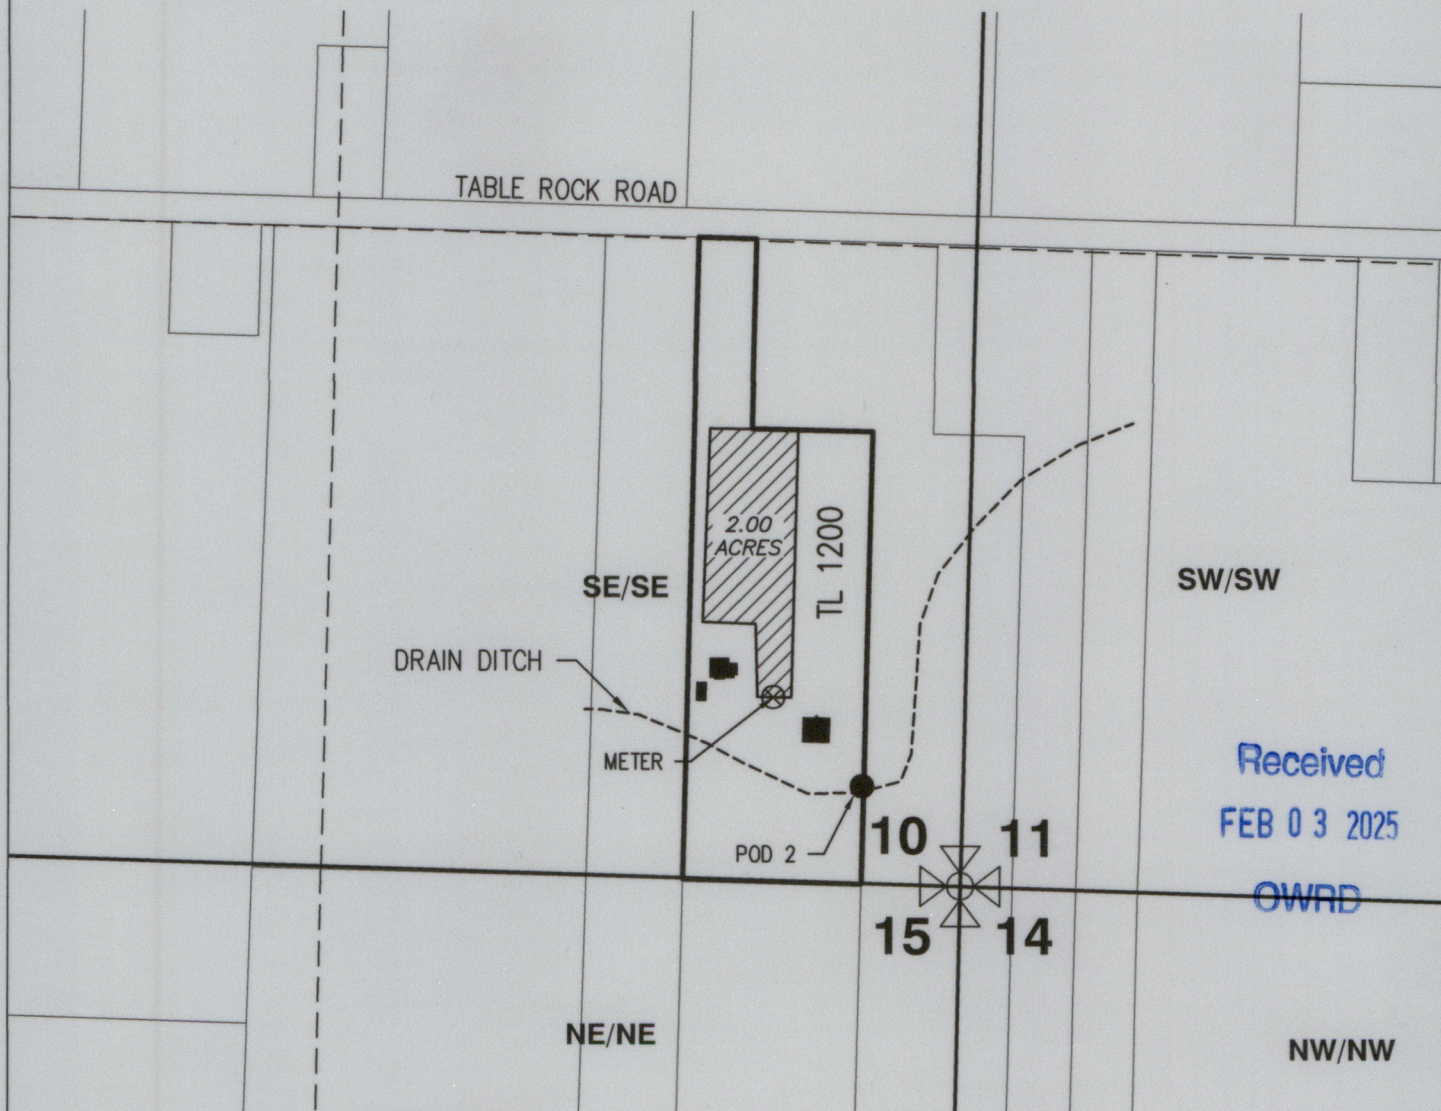

Received
FEB 03 2025
OWRD

LEGEND

- **POD 2**
218' NORTH AND 220' WEST
OF SE CORNER SECTION 10.
- DRAIN DITCH No. 1, DIVERSION
No. 2

- PLACE OF USE
IRRIGATION
- 1/4-1/4
SECTION LINE
- DRAIN DITCH

This map is not intended to
provide legal dimensions or
locations of property
ownership lines.

EHM-January 22, 2025
ROGUE CIVIL LLC
emalepsy@roguecivil.com 541-621-2868