


# Claim of Beneficial Use

## Permit S-46813, Application S-61486

A Water Right held by Daniel Arriola  
Coos County

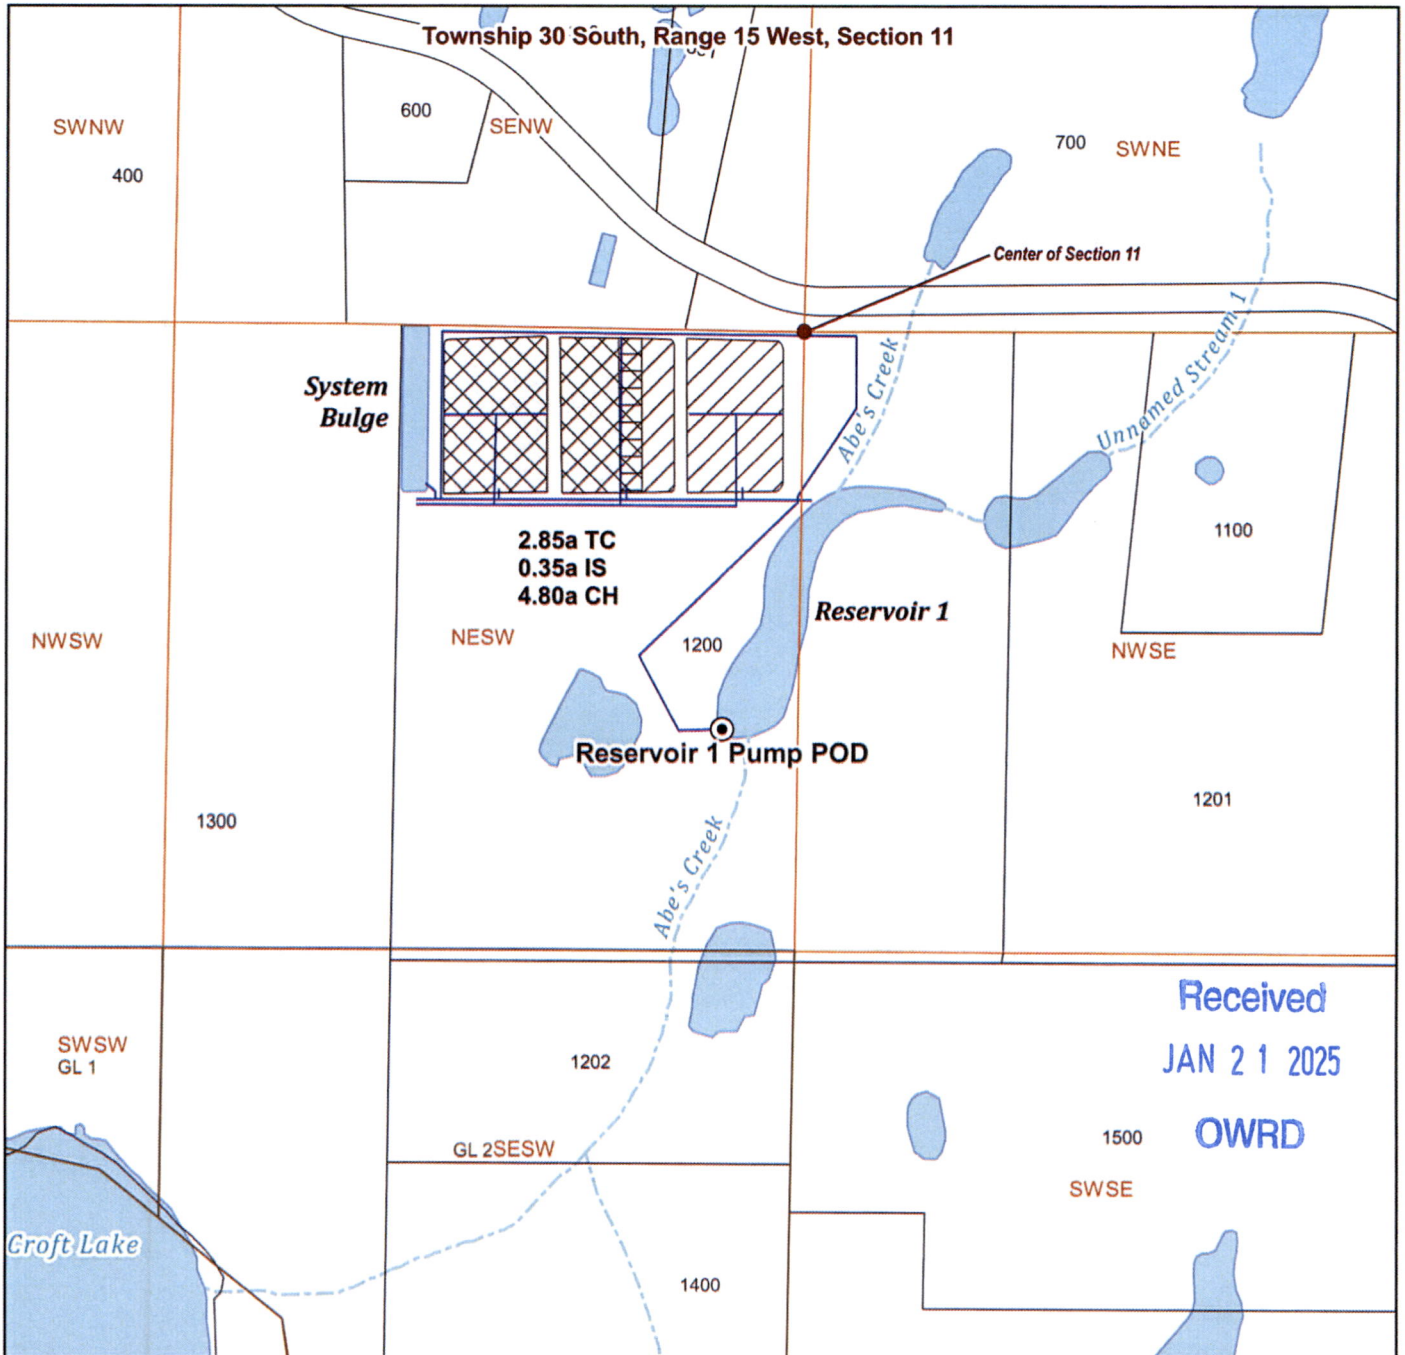

### LEGEND

- Tax lots
- Intermittent Watercourse
- Water Conveyance Mainlines
- Point of Diversion (POD)

### Place of Use (POU)

- Supplemental Irrigation (IR under Cert. 51557)
- ▨ Temperature Control
- ▨ Flood Harvest

### POD Location Description

**Reservoir 1 Pump POD**  
Located 820 feet South and 165 feet West from center of Section 11 (NESW), Township 30 South, Range 15 West, W.M.



Scale  
0 200 400 ft  
1-inch = 400 feet

Date: 9/2/2024  
Data Sources: BLM, OWRD, OGEO, USGS, Coos County.  
Disclaimer: This map is not intended to provide legal dimensions or property ownership lines.

Received  
JAN 21 2025

OWRD  
SWSE

