


Claim of Beneficial Use

Permit R-8662, Application R-63735

A Water Right held by Daniel Arriola, Anthony Arriola, and Arriola Cranberry Company LLC
Coos County

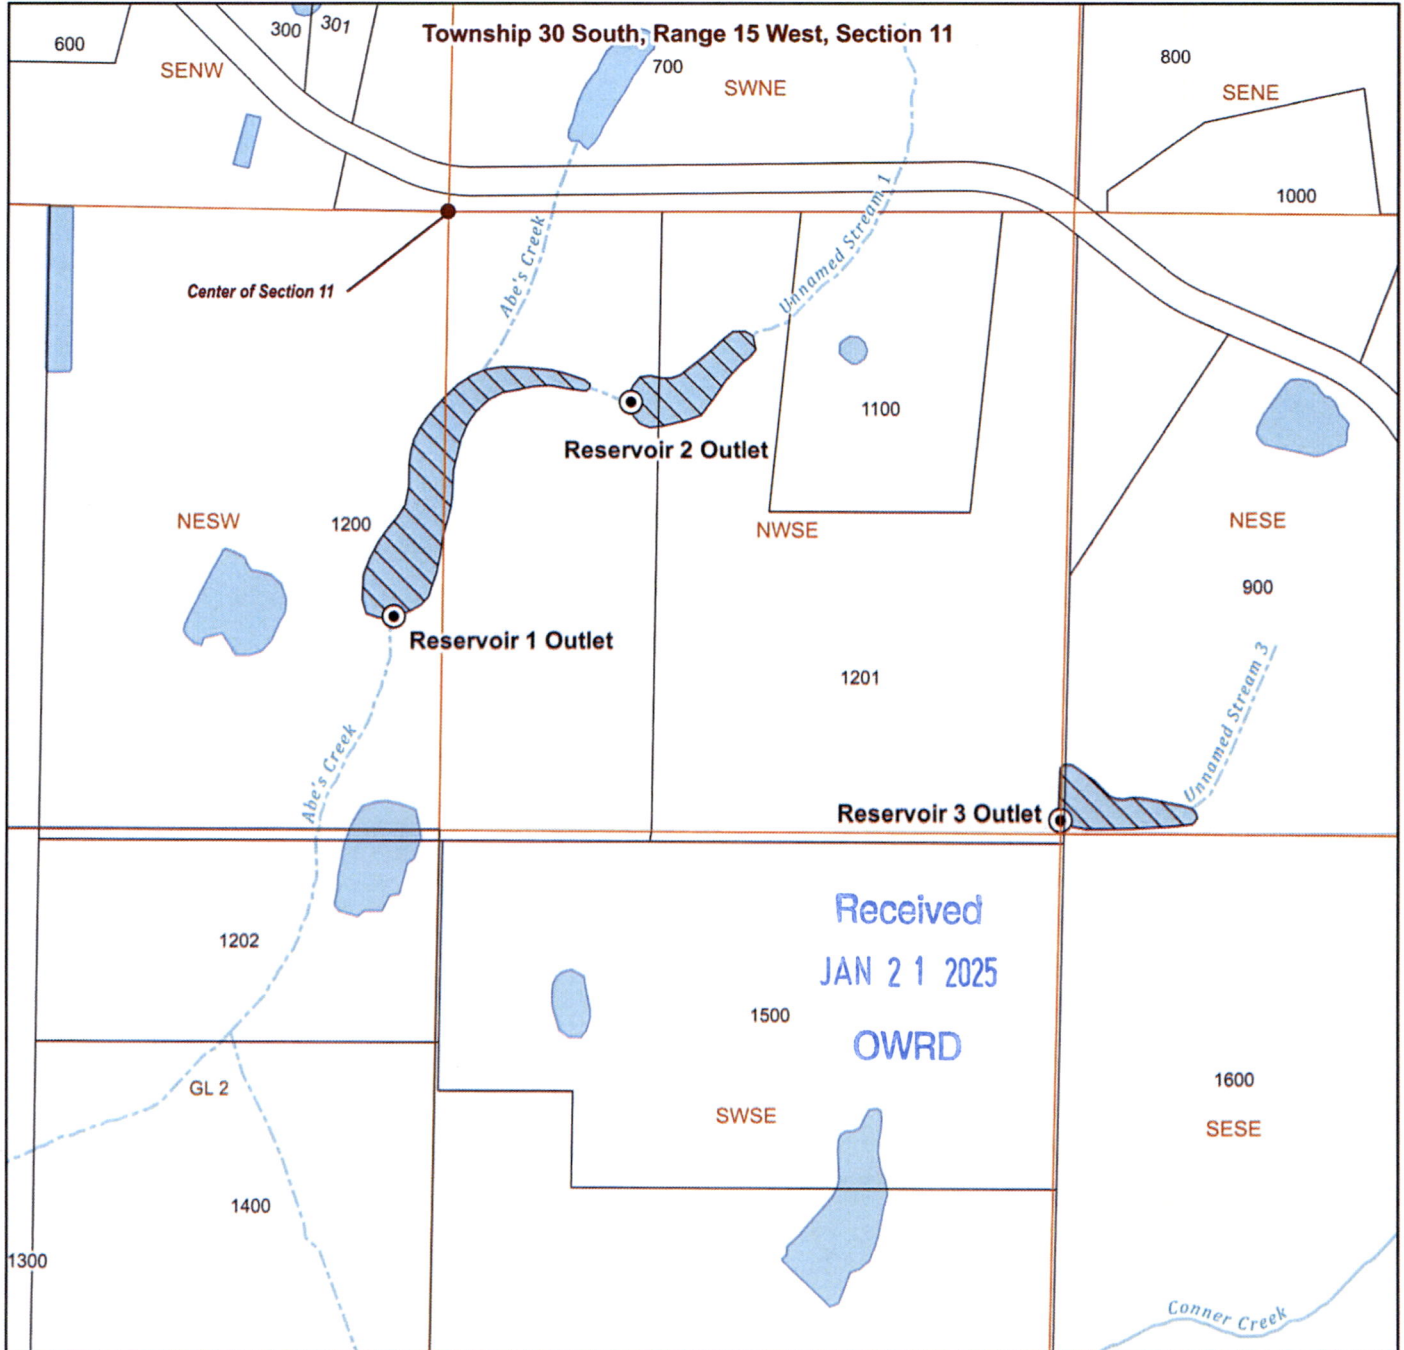

Received
JAN 21 2025
OWRD

LEGEND


- Point of Diversion (POD)
- ▨ Place of Use (POU)
- Perennial Watercourse
- - - Intermittent Watercourse

POD Location Description

Reservoir 1 Outlet
Located 840 feet South and 105 feet West from center of Section 11 (NESW), Township 30 South, Range 15 West, W.M.

Reservoir 2 Outlet
Located 400 feet South and 390 feet East from center of Section 11 (NWSE), Township 30 South, Range 15 West, W.M.

Reservoir 3 Outlet
Located 1262 feet South and 1305 feet West from center of Section 11 (NESE), Township 30 South, Range 15 West, W.M.

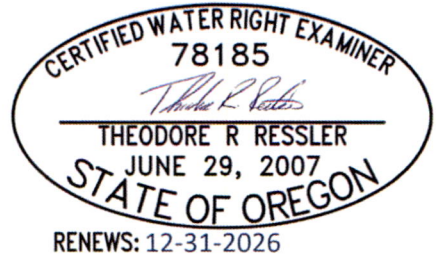

Date: 12/26/2024
Data Sources: BLM, OWRD, OGEO, USGS, Coos County.
Disclaimer: This map is not intended to provide legal dimensions or property ownership lines.

