



T.4S. R.1E. Section 2, W.M.

Township 3S 35 36
Township 4S 2 1

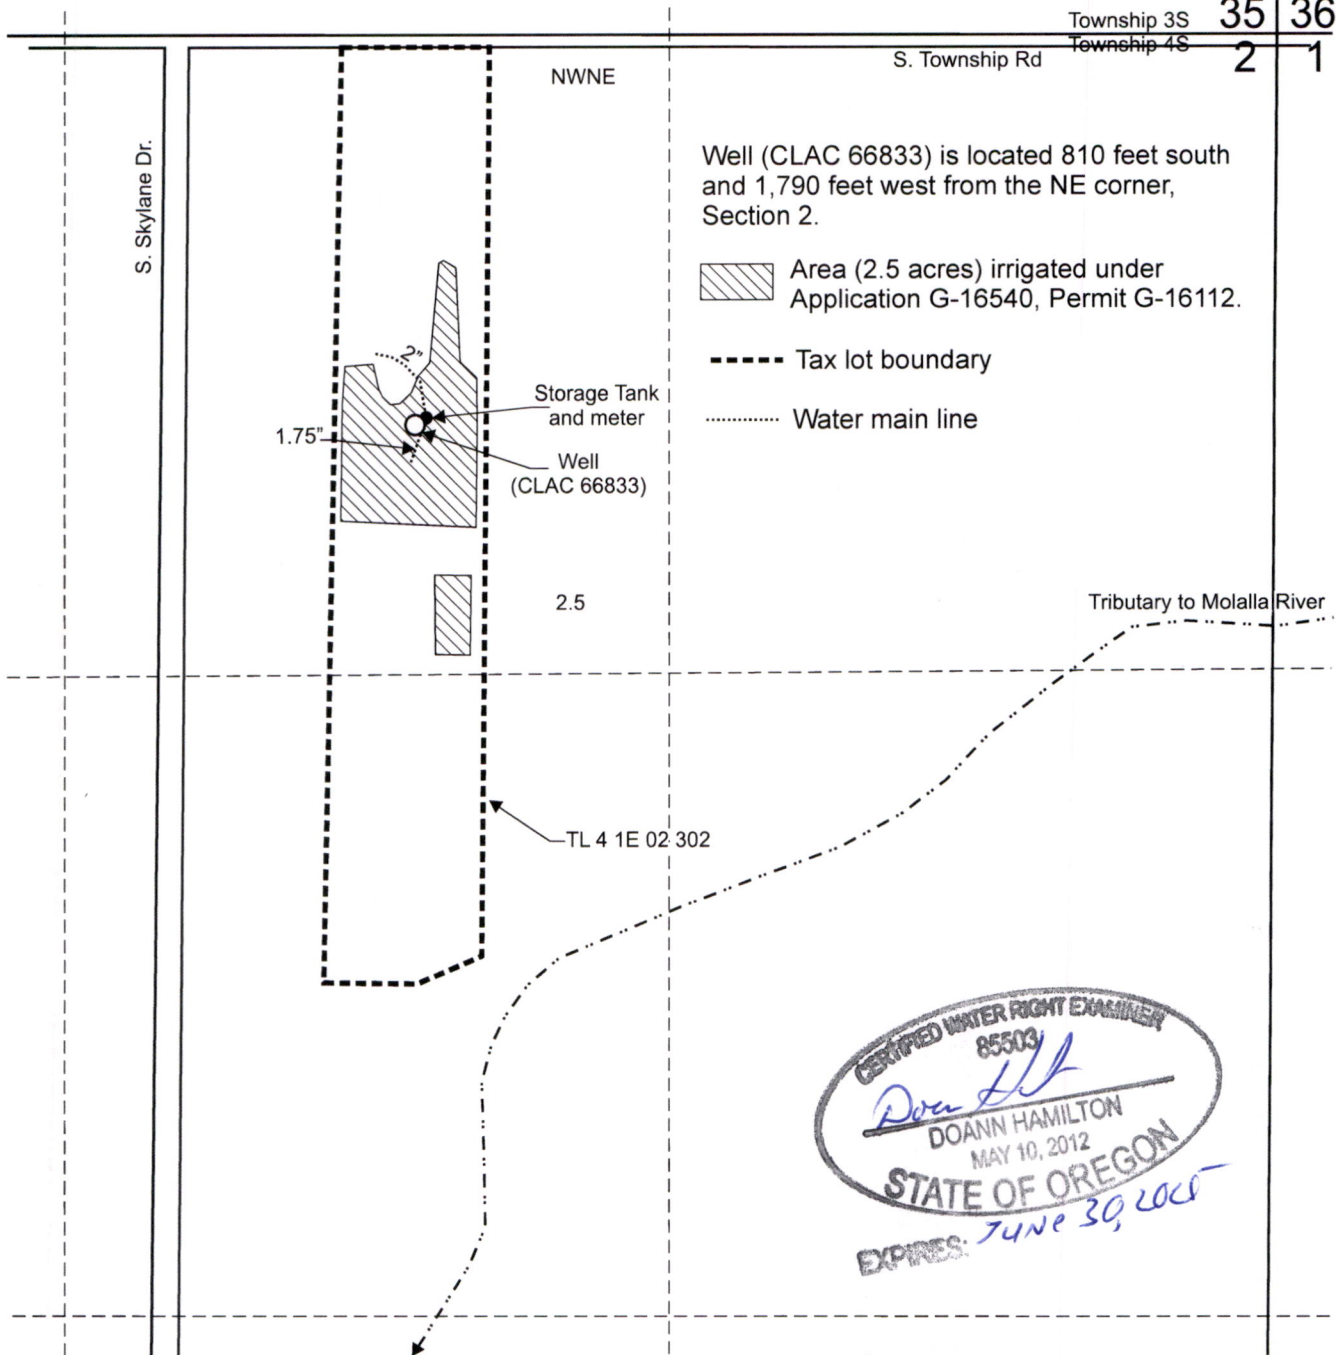

Received
FEB 05 2025
OWRD

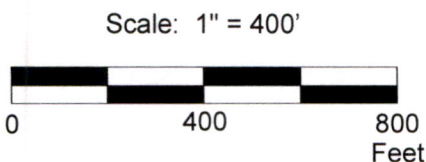

This map was prepared for the purpose of identifying the location of a water right only and is not intended to provide legal dimensions or location of property ownership lines.

Claim of Beneficial Use Map
Application G-16540, Permit G-16112

William, Sharyn and Colin Park

Pacific Hydro-Geology Inc.

01/2025