



T.4S. R.1E. Sec. 27 & 34, W.M.

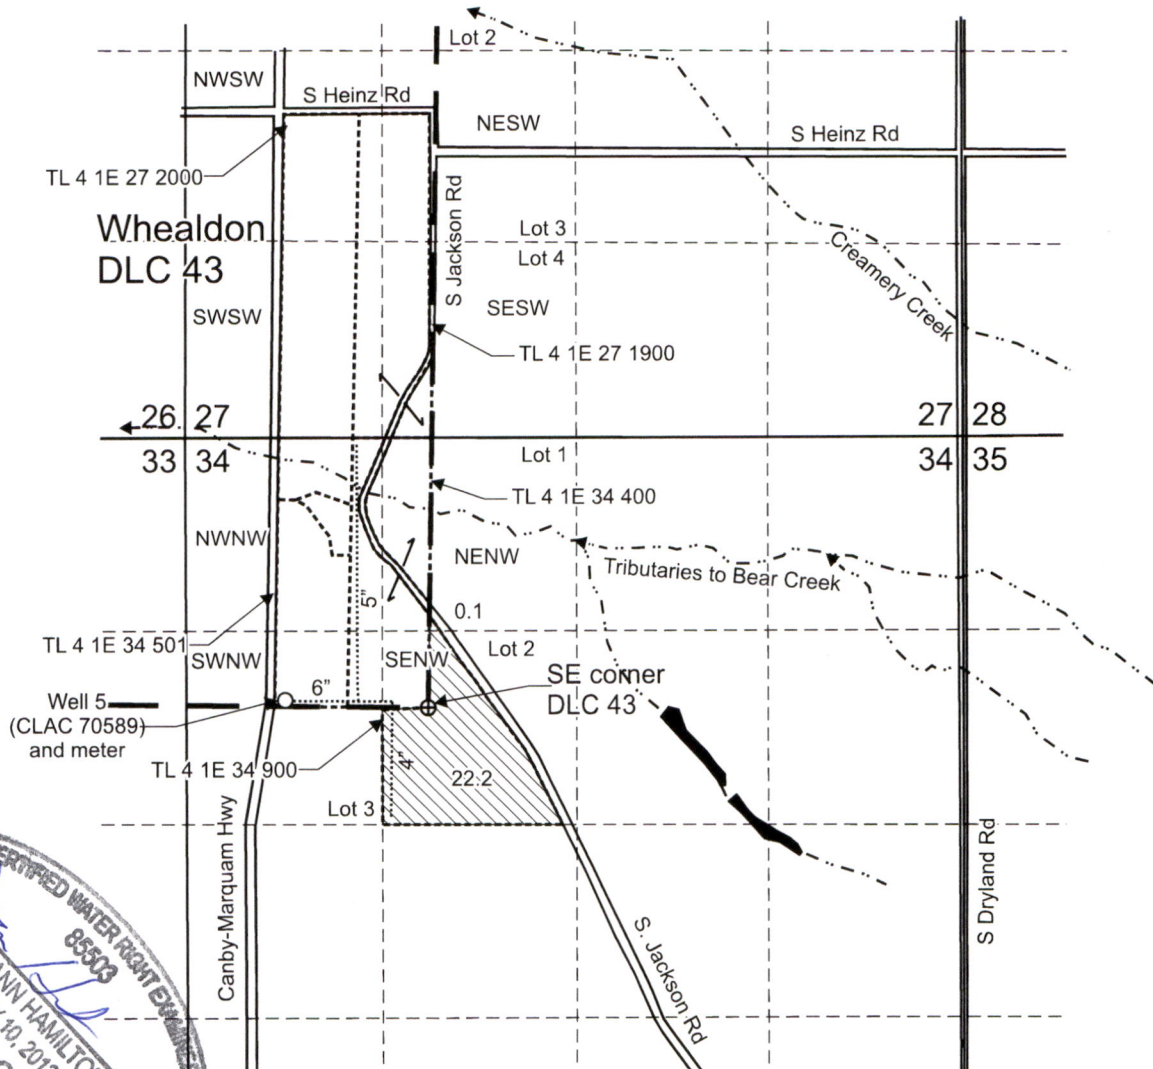

Well 5 (CLAC 70589) is located 50 feet north and 980 feet west from the SE corner, DLC 43.

 Area (22.3 Acres) irrigated under T-11659, formerly Certificate 88216, priority date: 5-31-1983.

----- Tax lot boundary

— . — Donation Land Claim boundary

..... Water main line

Scale: 1" = 1,320'



This map was prepared for the purpose of identifying the location of a water right only and is not intended to provide legal dimensions or location of property ownership lines.

Claim of Beneficial Use Map
T-11659, formerly Certificate 88216

Berry Pro LLC
T.4S. R.1E. Sec. 27 & 34, W.M.

Pacific Hydro-Geology Inc.

11/2024

Received
FEB 05 2025
OWRD

