


Received
 DEC 18 2024
 OWRD


Township 5 S Range 1 E

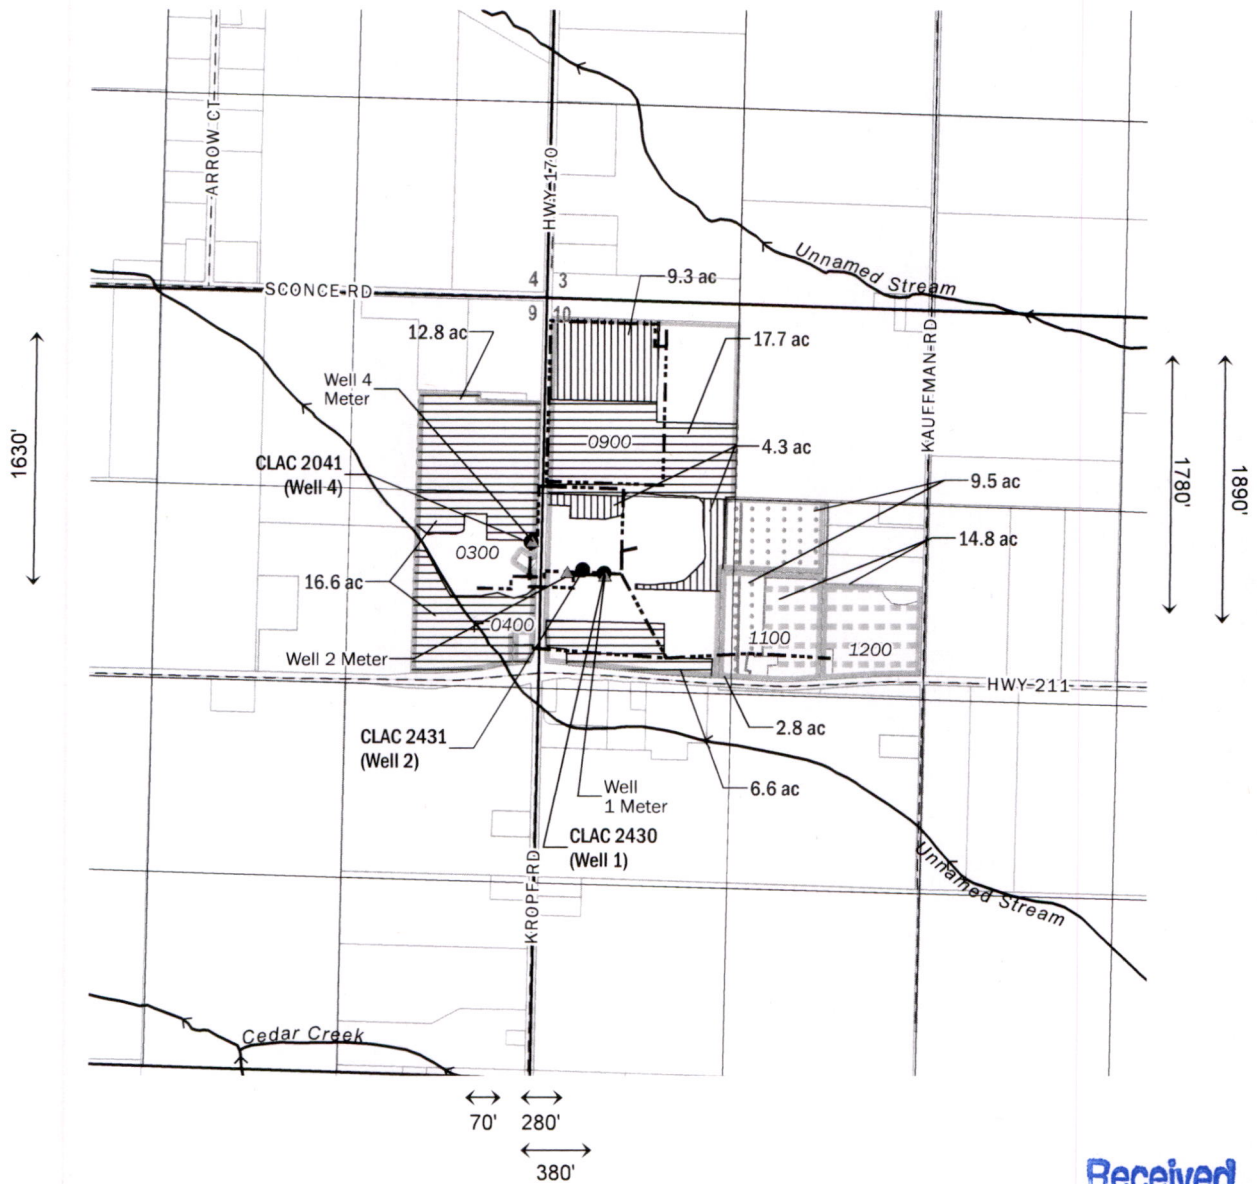

This map is not intended to provide legal dimensions or locations of property ownership lines.

Received
 FEB 07 2025
 OWRD

- | | | |
|------------------------------------|----------------------|-------------------------------|
| Existing Place of Use - Irrigation | ● Point of Diversion | □ Section |
| Certificate 42788 | ▲ Flow Meter | □ Quarter Quarter |
| Certificate 44577 | ← Stream | □ Clackamas County Tax Parcel |
| Added | --- Source Pipe | □ Willamette Egg Farms Parcel |
| Certificate 42788 | | |
| Certificate 44577 | | |

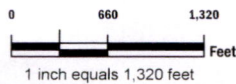

Transfer T-11366
 Claim of Beneficial Use
 Willamette Egg Farms
 Clackamas County, Oregon

Geosyntec
 consultants

OCT-2024

PROJECT NO.
 PNW0495

BY
 KAM / KMJ

REVISED BY
 --- / ---

FIGURE NO.

1