


TOWNSHIP 15 SOUTH, RANGE 9 W, W.M.

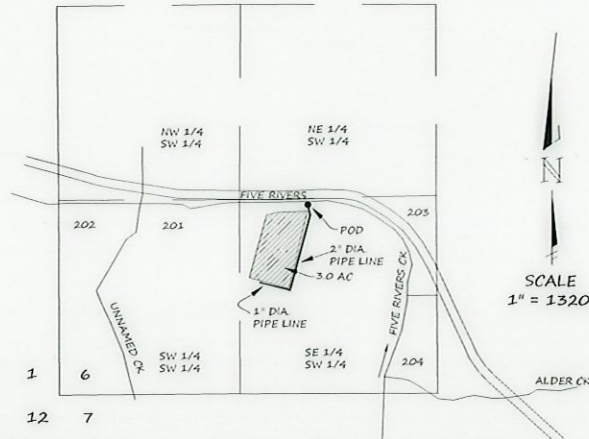

TRANSFER PERMIT T-13871 SPECIAL ORDER VOL. 131, PG 885

POD LOCATION
POD = 1314' NORTH & 1709' EAST OF SW COR. SEC. 6
FISH SCREEN, METER & PUMP LOCATED AT POD



DENOTES AREA OF BENEFICIAL USE

NOTE:
THIS MAP WAS PREPARED FOR THE
PURPOSE OF IDENTIFYING THE LOCATION
OF THE WATER RIGHT ONLY. IT IS
NOT INTENDED TO PROVIDE DIMENSIONS
OR LOCATION OF PROPERTY OWNERSHIP
LINES.

CLAIM OF BENEFICIAL USE MAP

FOR

SALLY HOUCK

121 E. CRAB CREEK

TIDEWATER, OR 97390


BY

H. TIMOTHY FASSBENDER, PLS, CWRE

2896 SARAH LANE

EUGENE, OR 97408

DECEMBER 13, 2024

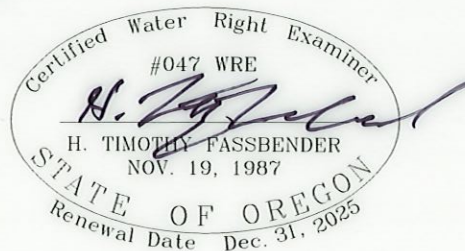

Received

FEB 18 2025

OWRD