


1" = 1320'
Tax Lot: 202
16 south 5 west

RECEIVED

JUN 21 2022

OWRD

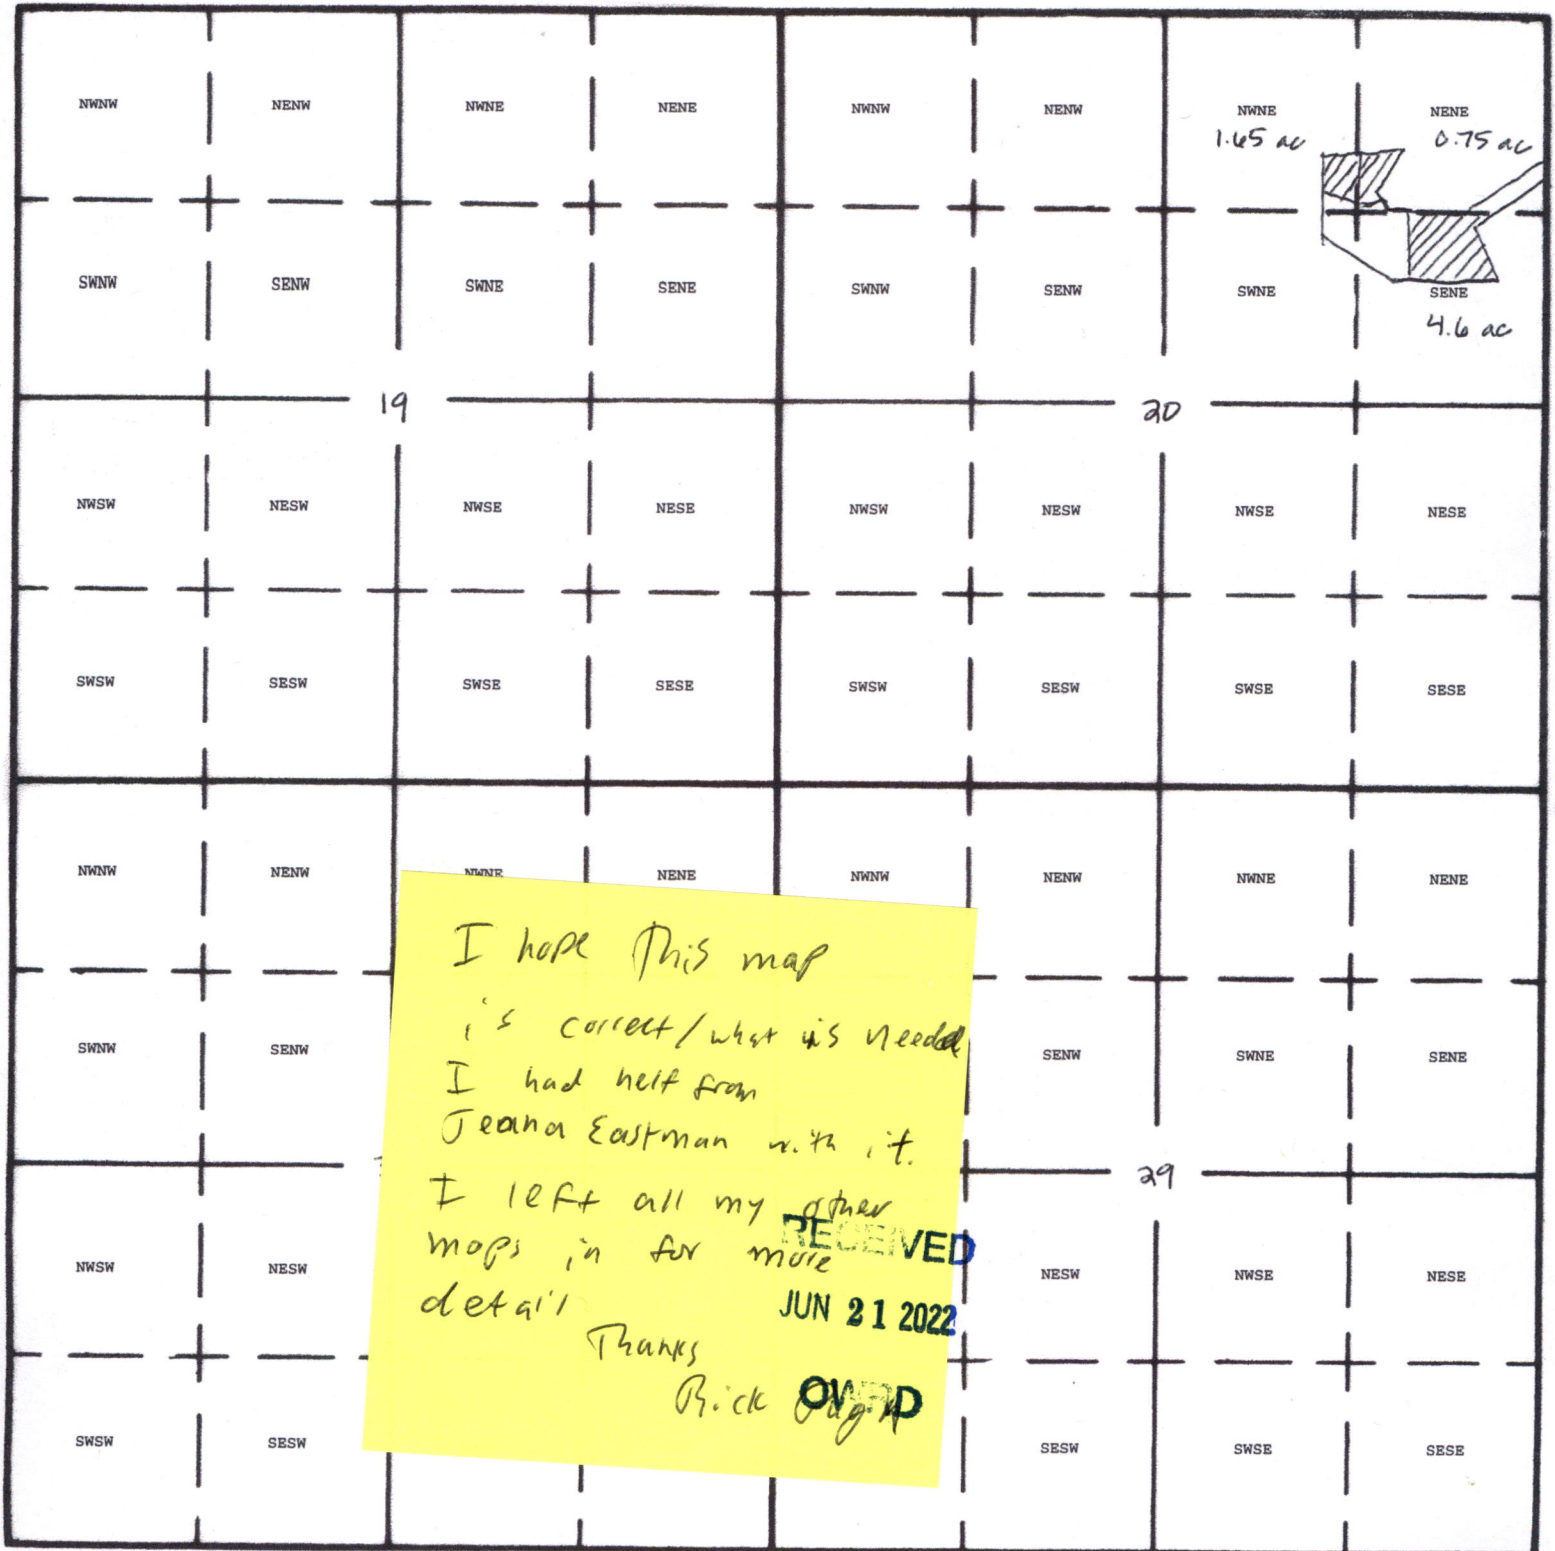

I hope This map
is correct/what is needed
I had help from
Jeana Eastman w. it.
I left all my other
maps in for more
detail
Thanks
Rick O'Connell

RECEIVED
JUN 21 2022

OWRD

South

Well location: 180 feet south & 200 feet west from NE corner, SENE, Section 20