


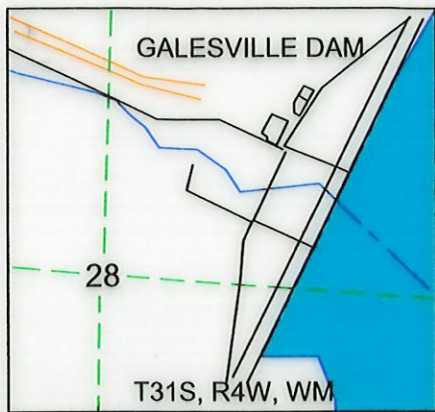


CLAIM of BENEFICIAL USE

FOR KYLE & CHARLENE HENRIKSON
BY NATHAN REED PE CWRE
T27S, R6W, W.M. SECTION 5, GLOT 1
APPLICATION NO.: S-89135
PERMIT NO.: S-55331

DATE OF SURVEY: OCTOBER 12, 2023

SCALE: 1" = 400'

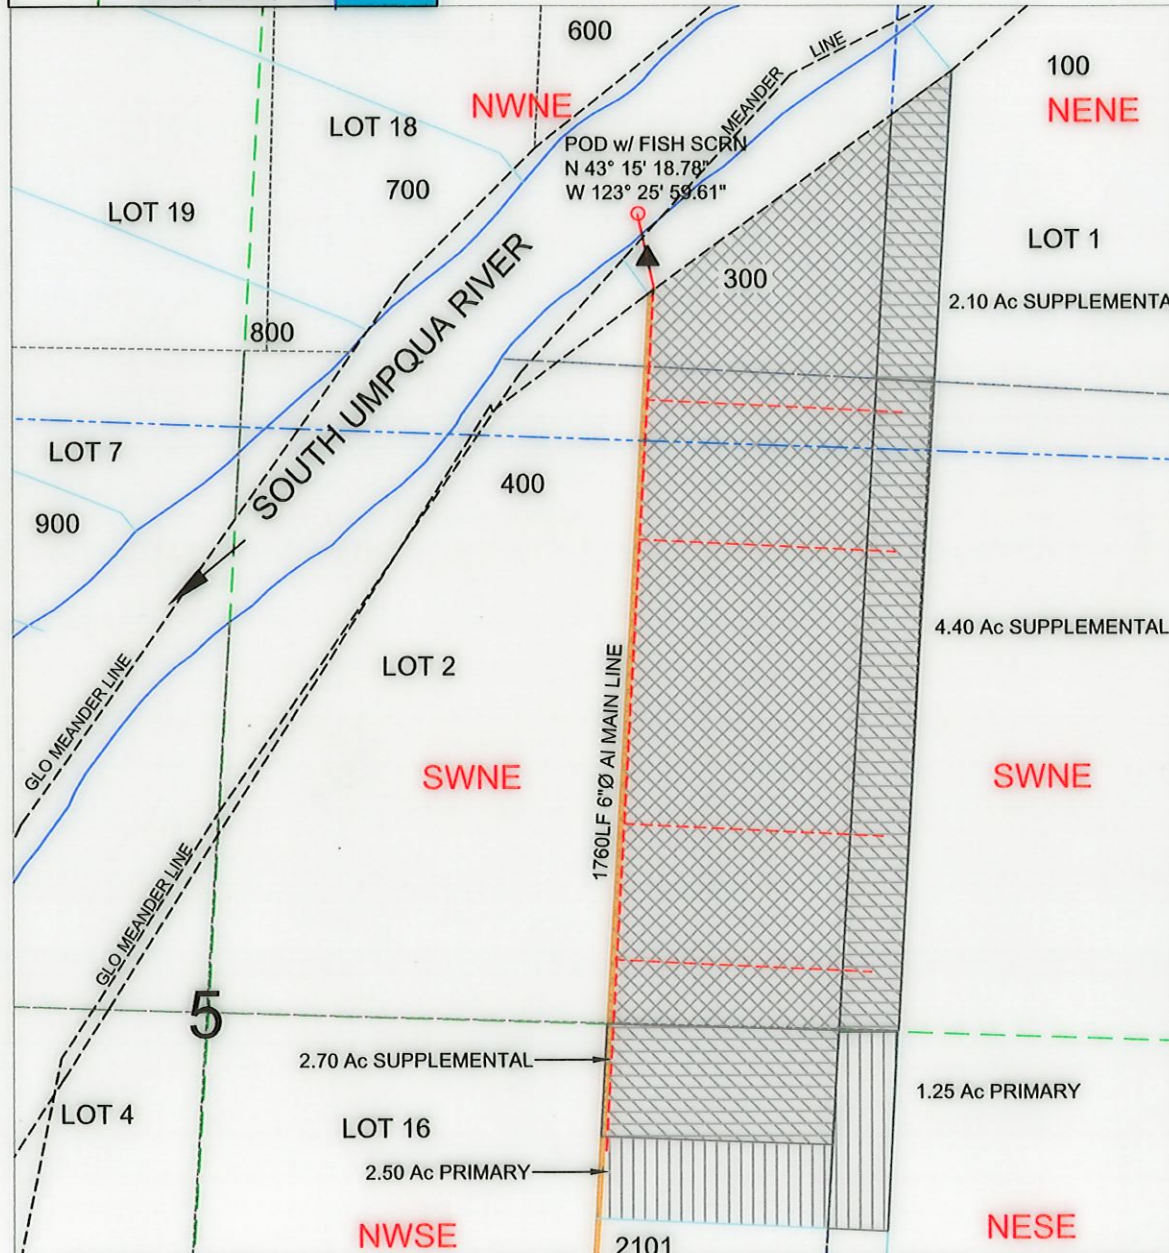

- LEGEND**
- WATER/STREAM
 - POD
 - ▲ PUMP
 - PIPELINE
 - SECTION
 - QUARTER
 - MEANDER
 - SIXTEENTH
 - GOV LOT
 - PARCEL
 - ▨ CERT #49775, PRI 27.78
 - ▩ CERT #91667, SUP 18.60
 - ▤ PRIMARY, GALESVILLE
 - ▥ SUPPL., GALESVILLE

Received
FEB 14 2025
OWRD



POD IS LOCATED 1050 FEET SOUTH AND 1800 FEET WEST FROM NE CORNER, SECTION 5 WITHIN GLOT 1.

MAP PREPARED FOR:
KYLE & CHARLENE HENRIKSON
2545 DAIRY LOOP RD
ROSEBURG, OR 97471

THE PURPOSE OF THIS MAP IS TO IDENTIFY THE LOCATION OF THE WATER RIGHT. IT IS NOT INTENDED TO PROVIDE INFORMATION RELATIVE TO THE LOCATION OF PROPERTY OWNERSHIP BOUNDARY LINES.

MAP PREPARED BY:
NATHAN REED PE, CWRE
157 WEST BODIE STREET
ROSEBURG, OR 97471