


Claim of Beneficial Use - Peterson

Application G-18616, Permit G-18227

Township 16S, Range 4W, W.M.

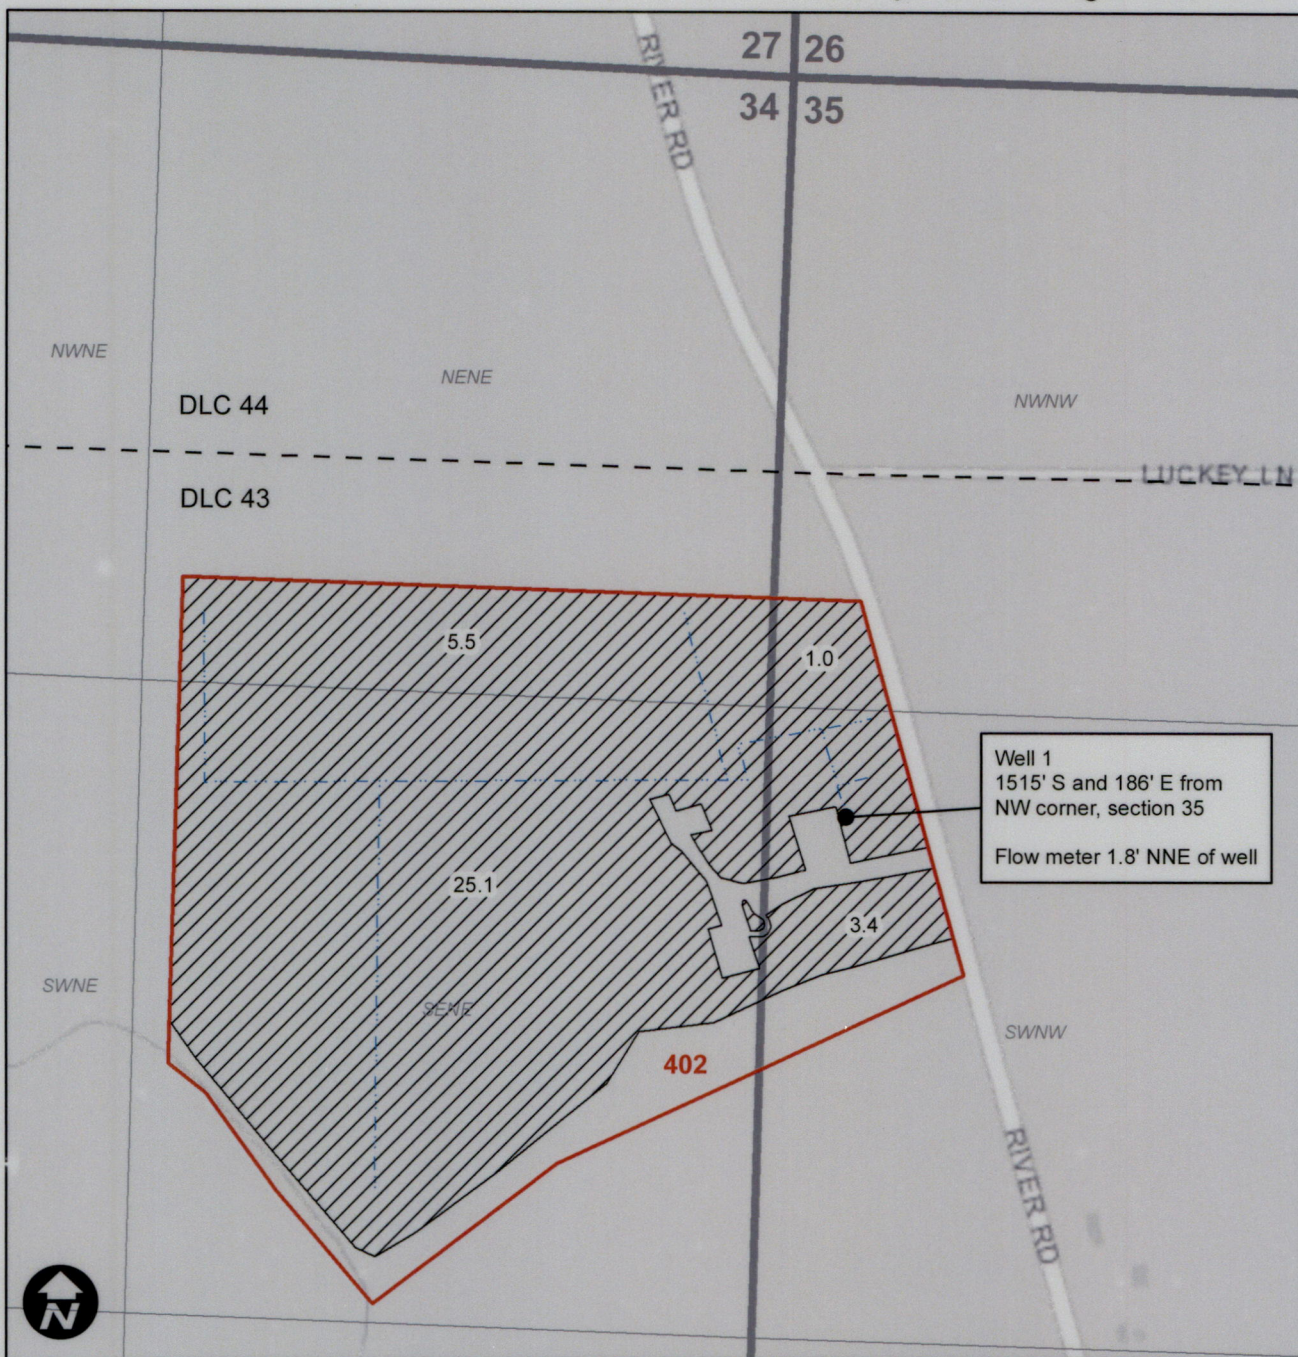


0 200 400 800 Feet

This map is not intended to provide legal dimensions or locations of property ownership lines.

Legend

IR POU Mainline Taxlot DLC

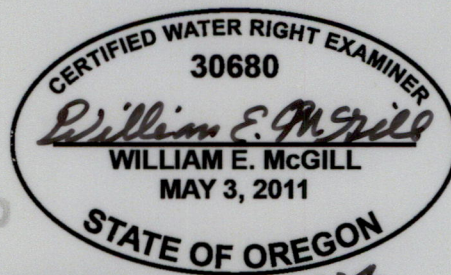

Received by OWRD

FEB 26 2025

EXPIRES: 12-31-2024

Salem, OR