


Claim of Beneficial Use - Setniker Trading Co., LLC
 Application S-87946, Permit S-54942

Township 8/9S, Range 4W, W.M.

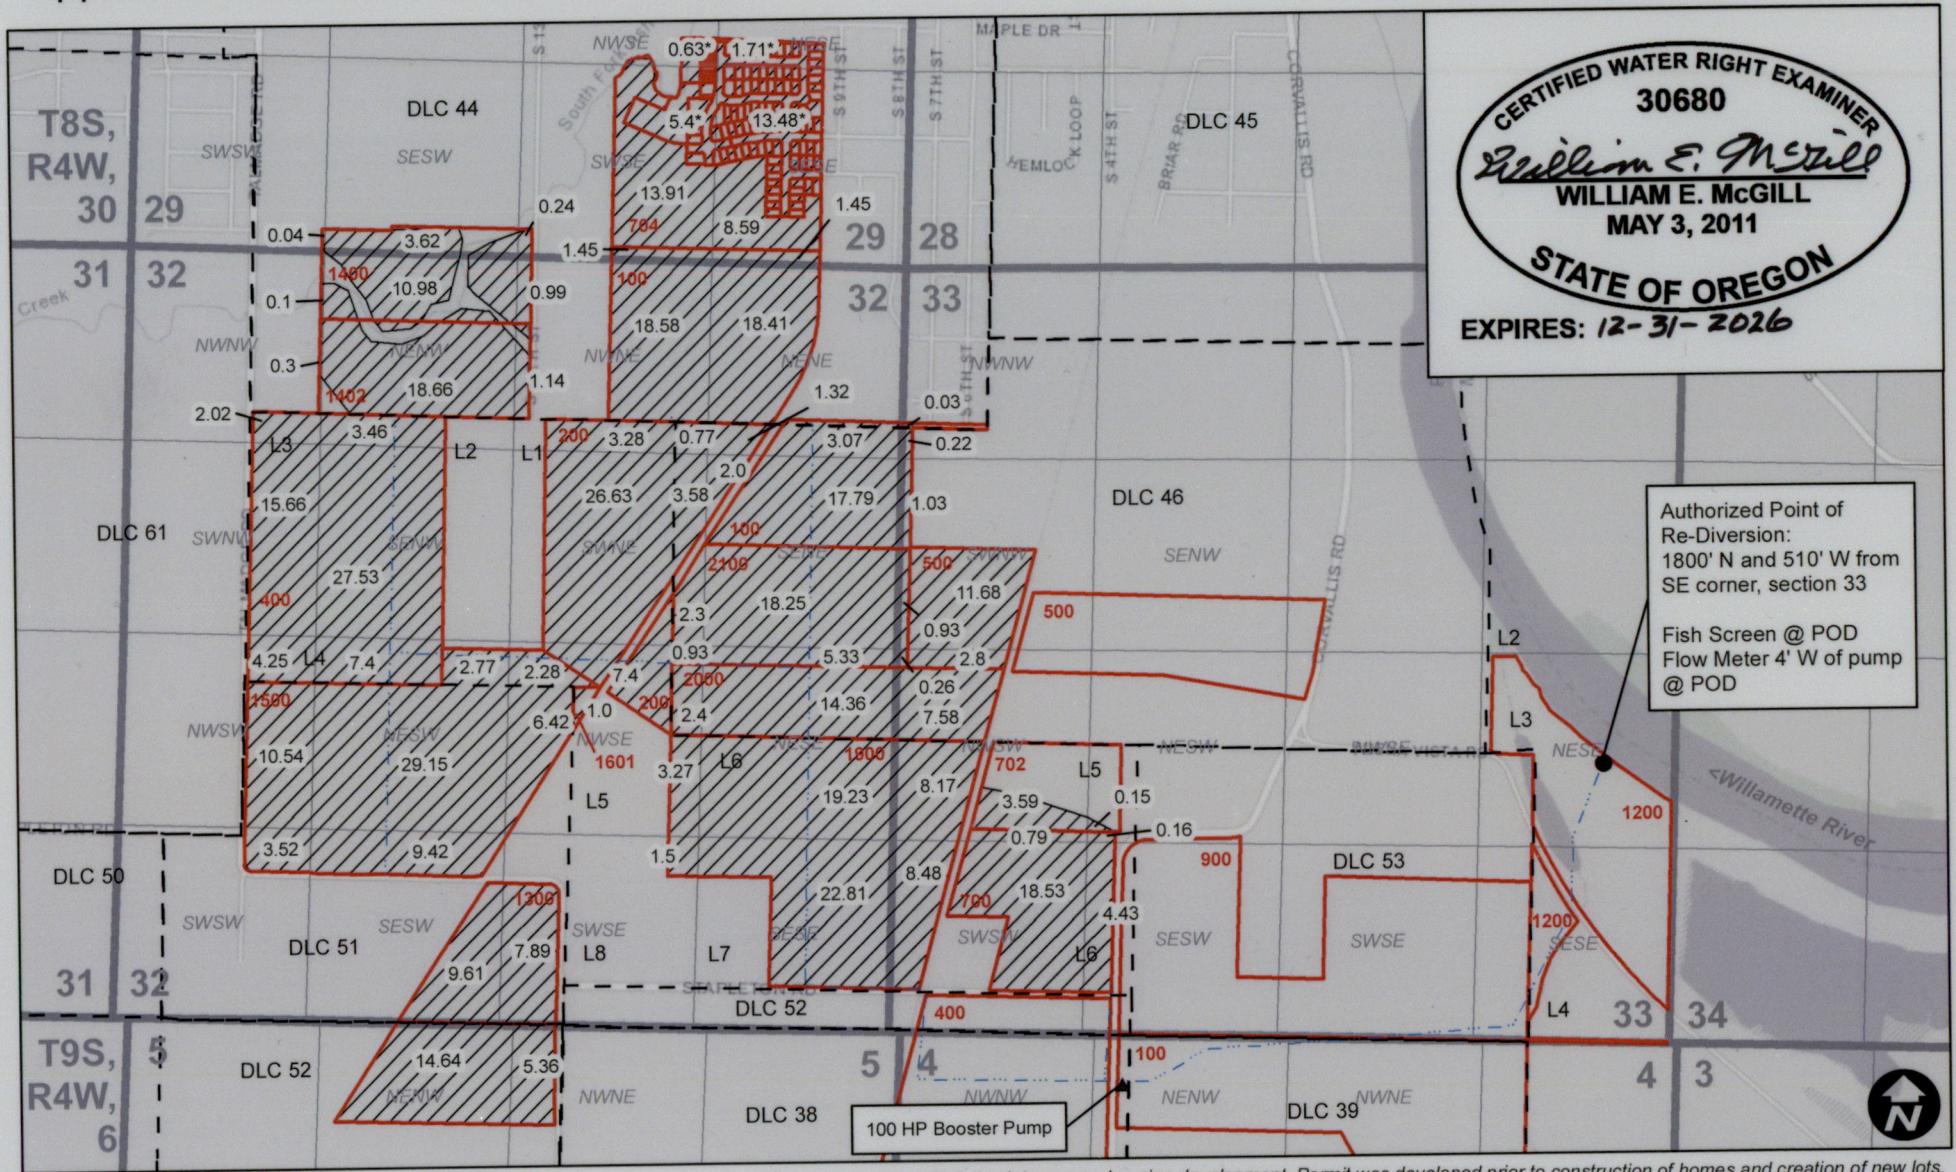

CERTIFIED WATER RIGHT EXAMINER
 30680
William E. McGill
 WILLIAM E. MCGILL
 MAY 3, 2011
 STATE OF OREGON
 EXPIRES: 12-31-2026


Authorized Point of Re-Diversion:
 1800' N and 510' W from SE corner, section 33
 Fish Screen @ POD
 Flow Meter 4' W of pump
 @ POD

*Acreage covers multiple tax lots on new housing development. Permit was developed prior to construction of homes and creation of new lots.
 This map is not intended to provide legal dimensions or locations of property ownership lines.

Legend

- IR POU
- Mainline
- DLC
- Taxlot

Received by OWRD

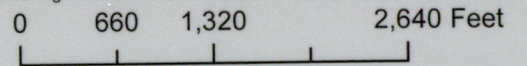

FEB 26 2025