

**WELL LOCATION:**  
 WELL 1: 1,510' NORTH AND 1,950' WEST FROM THE SE CORNER OF SECTION 2.

**NOTES:**  
 1. THIS MAP WAS PREPARED FROM FIELD MEASUREMENTS, NAIP 2025 AERIAL PHOTOGRAPHY, KLAMATH COUNTY TAX MAPS AND OREGON GLO MAPS.

2. THE PURPOSE OF THIS MAP IS TO IDENTIFY THE LOCATION OF THE WATER RIGHT ONLY, AND IS NOT INTENDED TO PROVIDE DIMENSIONS OR LOCATION OF PROPERTY LINES.

3. DATE OF PRIORITY FOR THIS WATER RIGHT IS JUNE 7, 2001.


**LEGEND**

	SECTION LINE		FLOW DIRECTION
	1/4 1/4 LINE		SECTION CORNER
	TAX LOT LINE	TL	TAX LOT NUMBER
	CANAL/CREEK	0000	GOVERNMENT LOT NUMBER
	MAINLINE	LOT 1	WELL
	ROAD		PUMP
	IRRIGATED ACRES		IRRIGATED UNDER PERMIT G-15075
	1/4 1/4 SECTION		
	IRRIGATED ACRES		
	GOVERNMENT LOT NUMBER		
	PROJECTED 1/4 1/4 SECTION		

Received by OWRD

MAR 06 2025

Salem, OR

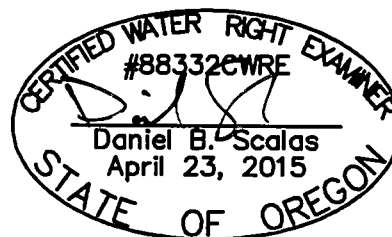

RENEWAL 06/30/26

**ALADKINS** ENGINEERING & SURVEYING o / 541.884.4666 w / AdkinsEngineering.com

1435 ESPLANADE AVENUE, KLAMATH FALLS, OR 97601

SERVING S. OREGON & N. CALIFORNIA

**CLAIM OF BENEFICIAL USE AND FINAL PROOF MAP**

FOR  
 JIM MCKOEN; JEANNIE LYON  
 T41S, R11E, SEC. 2, WM  
 KLAMATH COUNTY, OREGON  
 PERMIT G-15075  
 APPLICATION G-15524