


FOR HB 2153

11-29-1991

Depth of water & height of Dam

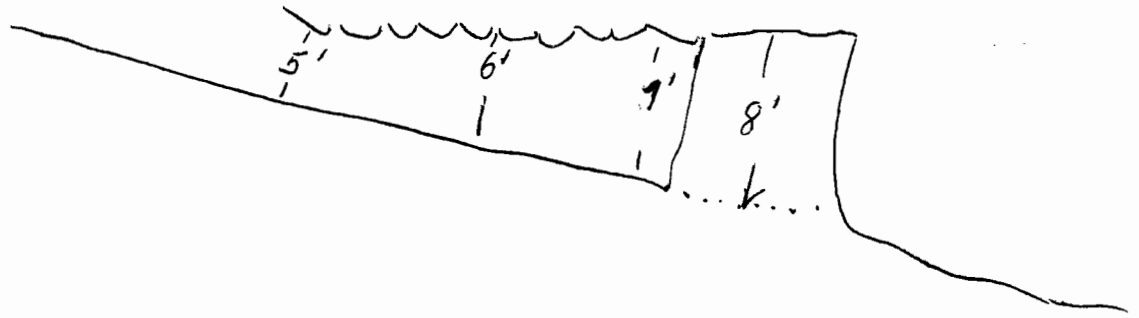

This property has 7.1 acres irrigated with water from Eagle Point Irrigation District. It is the first Lateral on "adder lick" the ditch from the big canal. Many times the runoff is 4 or 5 times greater than the irrigation flow. I set the gates so it will fill the pond. There is also seepage from the ditch to the pond. I try to keep the water up a bit because I syphon water 200 yds to my garden as the well has Boron which is not good for house plants or vegetables.


The attached maps show the location of the reservoir the volume and depth of water. It was made for a log Pont for a sawmill around 1918.

It does not divert any water from any lake or stream.

attachments: #1 Reservoir area & volume

#2 Map showing location of reservoir

Pauline Landenslager x Lawrence C. Nielsen

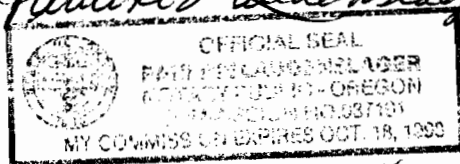

11 30 94

File P - 78000